

MISSISSIPPI BOARD OF WATER COMMISSIONERS

WATER WELL DRILLERS LOG

**CODED**

DeSoto  
 info. to locate  
 B 70  
 3-14-61  
 Date: March 14, 1961, Driller: Deep South Well County DeSoto  
 (Name)


(1) Owner of Land: Laurence Galvi  
 (Name)  
Tulane Rd., Memphis 16, Tenn.  
 (Address)  
 (2) Location: 1/4, 1/4, Sec. 20 T. 1 R. 8,  
3 miles N.W., of Horn Lake  
 (distance) (direction) (Nearest Town)  
 (3) Topography: Flat  
 (Hilly) (Flat) (Level)  
 (4) Purpose of Well: Irrigation  
 (Domestic Irrigation  
 Municipal, Industrial, Other)

Description & Color of Materials Sand, Clay, Red Clay, Shell, etc.	Thick- ness Feet	Depth Feet
0-25 Surface clay	25	
25-49 Sand, some gravel	24	
49-50 Soft rock	1	
50-58 Hard lignite	8	
58-105 Fine sand, blue	47	
105-203 Sticky blue clay	98	
203-237 Blue clay, sand	34	
237-247 Med. sand strks	10	
247-265 Coarse & med. coarse	18	

Information upon completion of well:

(1) Diameter 4 inches.  
 (2) Total Depth 265 feet.  
 (3) Water Level 38 feet below top of ground.  
 (4) Cased to None, Size \_\_\_\_\_  
 (5) Screen: Size 2 1/2", Length 15 ft  
 (6) Were any formations sealed against pollution?  
 \_\_\_\_\_ yes, No no.

**CODED**

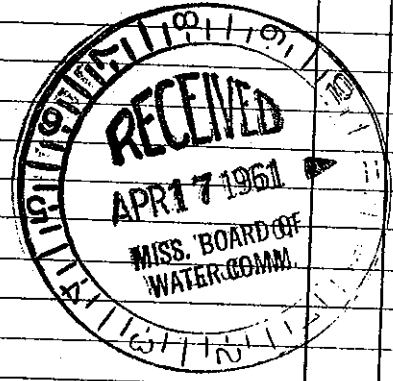

If YES depth of formation \_\_\_\_\_  
 Why \_\_\_\_\_  
 Drillers Remarks: \_\_\_\_\_

Well No. \_\_\_\_\_

(Use Back Side)