

DESOTO MISSISSIPPI BOARD

B43

WATER WELL DRILL

11-29-63

Date: 11-29-63, Driller: C. B. [Signature] County: Desoto

**CODED**

(1) Owner of Land: RAW. ROWSEY  
 (Name)  
HORN LAKE MISS  
 (Address)

(2) Location:  $\frac{1}{4}$ ,  $\frac{1}{4}$ , Sec. 35 T. 1 R. 8,  
1 miles S.E. of HORN LAKE  
 (distance) (direction) (Nearest Town)

(3) Topography: HILLY  
 (Hilly) (Flat) (Level)

(4) Purpose of Well: DOMESTIC  
 (Domestic Irrigation  
 Municipal, Industrial, Other)

Description & Color of Material Sand, Clay, Red Clay, Shell, etc.	Thickness Feet	Depth Feet
0 - 16 CLAY		
16 - 18 GRAVEL		
18 - 45 CLAY		
45 - 60 MUD & GRAVEL		
60 - 270 BLUE CLAY		
270 - 280 FINE SAND		
280 - 282 COARSE SAND		
282 - 292 FINE SAND		
292 - 299 MED-COARSE SAND		

Information upon completion of well:

(1) Diameter: 2 1/2 inches.


(2) Total Depth: 299 feet.

(3) Water Level: 94 feet below top of ground.

(4) Cased to: 295, Size: 2 1/2

(5) Screen: Size 2 1/2 x 4, Length 4

(6) Were any formations sealed against pollution?  
 yes,  no.

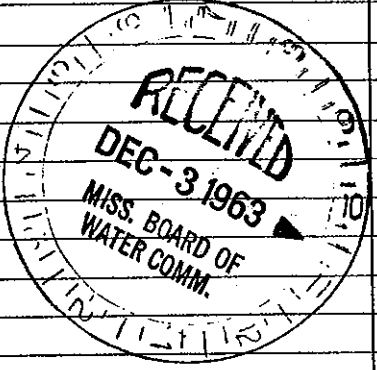

**CODED**

If YES depth of formation \_\_\_\_\_

Why: GENERAL PRACTICE

Drillers Remarks: CLAY PUDDLED FROM SURFACE — DID NOT DRILL THROUGH SAND

Well No.

(Use Back Side)