

DeSoto

B 44

1-10-63

MISSISSIPPI BOARD OF WATER COMMISSIONERS

WATER WELL DRILLERS LOG


CODED

Date: Jan. 10, 1963, Driller: Deep South Well Co. County: DeSoto

(Name)

(1) Owner of Land: <u>First DeSoto Corp.</u> (Name)	Description & Color of Materials Sand, Clay, Red Clay, Shell, etc.	Thick- ness Feet	Depth Feet
<u>Jackson, Miss.</u> (Address)	0-25 Surface clay	25	
(2) Location: <u>1/4, 1/4, Sec. 34</u> <u>35 T/R 8</u> <u>1</u> miles <u>S.E.</u> of <u>Horn Lake</u> (distance) (direction) (Nearest Town)	25-50 Sand & Gravel	25	
(3) Topography: <u>Hilly</u> (Hilly) (Flat) (Level)	50-56 Lignite	6	
(4) Purpose of Well: <u>Domestic</u> (Domestic Irrigation Municipal, Industrial, Other)	56-78 Fine sand, clay	22	
Information upon completion of well:	78-95 Lignite strks	17	
(1) Diameter <u>2 1/8</u> inches.	95-208 Blue sticky clay	113	
(2) Total Depth <u>337</u> feet.	208-250 Sandy blue clay	42	
(3) Water Level <u>105</u> feet below top of ground.	250-271 Fine sand	21	
(4) Cased to <u>None</u> , Size <u>None</u> .	271-282 Med. fine sand	11	
(5) Screen: Size <u>1 1/2"</u> , Length <u>8'</u> .	282-290 Med. coarse sand	8	
(6) Were any formations sealed against pollution? <u>no.</u>	290-304 Med. fine & fine sand	14	
If YES depth of formation _____	304-322 Med. sand	18	
Why _____	322-337 Coarse & med. coarse sand	15	
Drillers Remarks: _____			

CODED

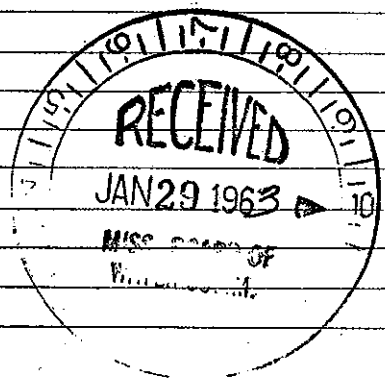

(Use Back Side)

Well No.

Mail this copy to Board of Water Commissioners 429 Miss. St. Jackson, Miss