

B 46  
6-24-64

WATER WELL DRILLERS LOG

CODED

Date: 6/24, 1964, Driller: Deep South Well Co. County: Desoto  
(Name)


	Description & Color of Materials Sand, Clay, Red Clay, Shell, etc.	Thick- ness Feet	Depth Feet
(1) Owner of Land: <u>Miss. Power &amp; Lt. Co.</u> (Name) <u>Jackson, Miss.</u> (Address)	0-25 Buckshot	25	
(2) Location: <u>1/4, 1/4, Sec. 26 T. 1 R. 8</u> <u>3/4 miles N.E.</u> of <u>Horn Lake</u> (distance) (direction) (Nearest Town)	25-32 Yellow Clay	7	
(3) Topography: <u>Flat</u> (Hilly) (Flat) (Level)	32-48 Red sand, some gravel	16	
(4) Purpose of Well: <u>Domestic</u> (Domestic Irrigation Municipal, Industrial, Other)	48-217 Blue clay	169	
	217-272 Fine sand	55	
	272-288 Med. Sand	10	
	282-328 Fine sand	46	
	328-336 Coarse & Med. Coarse sand	8	

Information upon completion of well:

- (1) Diameter 2 inches.
- (2) Total Depth 336 feet.
- (3) Water Level 58 feet below top of ground.
- (4) Cased to None, Size \_\_\_\_\_.
- (5) Screen: Size 1 1/2", Length 6 ft.
- (6) Were any formations sealed against pollution?  
\_\_\_\_\_ yes, X no.

If YES depth of formation \_\_\_\_\_  
Why \_\_\_\_\_  
Drillers Remarks: \_\_\_\_\_

CODED

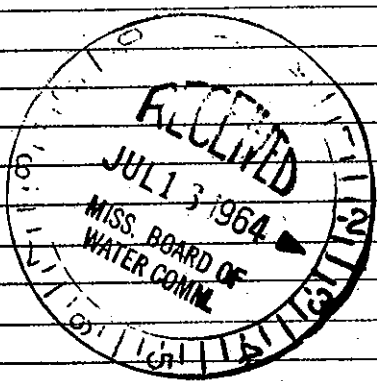

(Use Back Side)

Well No.