

Desoto  
B48  
1/66


MISSISSIPPI BOARD OF WATER COMMISSIONERS

WATER WELL DRILLERS LOG **CODED**

Date: 1-21, 1966, Driller: Watson Co. County Desoto  
(When well drilled) (Name) (Where well is located)

(1) Owner of Land: <u>Jerry Gay</u> <small>(Name)</small>	Description & Color of Materials Sand, Clay, Red Clay, Shell, etc.	Thick- ness Feet	Depth Feet
<u>Horn Lake, Miss.</u> <small>(Address)</small> <u>23 29 1 8</u> <u>NW 1/4</u>	<u>Surface Clay</u>		<u>30</u>
(2) Location: <u>1/4, 1/4, Sec. 19 T5 R w</u>	<u>Red Mud</u>		<u>40</u>
<u>3 1/2</u> miles <u>N.W.</u> , of <u>Horn Lake</u> <small>(distance) (direction) (Nearest Town)</small>	<u>Red Sand</u>		<u>50</u>
(3) Topography: _____ <small>(Hilly) (Flat) (Level)</small>	<u>yellow sand</u>		<u>60</u>
(4) Purpose of Well: <u>Domestic</u> <small>(Domestic Irrigation Municipal, Industrial, Other)</small>	<u>Coarse Sand &amp; Gravel</u>		<u>68</u>
Information upon completion of well:			
(1) Diameter <u>2 1/2</u> inches.			
(2) Total Depth <u>68' 9"</u> feet.			
(3) Water Level <u>48'</u> feet below top of ground.			
(4) Cased to <u>63'</u> , Size <u>2 1/2"</u>			
(5) Screen: Size <u>60 gauge 1/2 x 7/8</u> , Length <u>5' 9"</u>			
(6) Were any formations sealed against pollution? _____ yes, _____ no.			
If YES depth of formation _____			
Why _____			
Drillers Remarks: _____			
Yield in gpm: <u>not tested</u>			
Size pump: <u>Myers V2950 AM</u>			
Type power: <u>Elec.</u>			

**CODED**

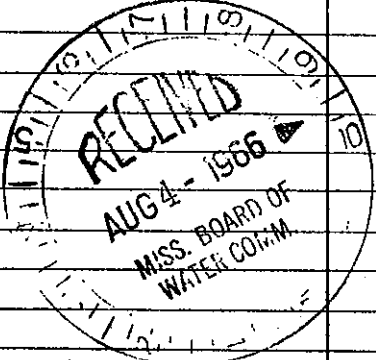

Mail this copy to Board of Water Commissioners 429 Miss. St. Jackson, Miss.