

**De Soto**  
**B55**  
**8-18-73**

MISSISSIPPI  
 BOARD OF WATER COMMISSIONERS  
 416 North State Street  
 Jackson, Mississippi 39201

**CODED**

**WATER WELL DRILLERS LOG**

8-18-1973 date well completed  
 Sub Smith firm name  
 De Soto county well located

**LANDOWNER:**

B. H. Shackelford  
 Horn Lake - Miss  
 (mailing address)

**description of formations encountered**

Top soil  
 Red clay  
 sand & gravel

from	to
0'	5'
5'	50'
50'	90'

**WELL LOCATION:**

sec. 20 T. 1 N R. 8 E  
 4 1/2 miles NW of Horn Lake  
 (distance) (direction) (nearest town)

**WELL PURPOSE:**

Stone  
 (home, irrigation, municipal, industrial)

**WELL COMPLETION DATA:**


- (1) diameter (inches) 4
- (2) total depth (feet) 90
- (3) static water level (feet) 18 below above top of ground.
- (4) casing (material) Plastic (depth) 90
- (size) If telescope see back.
- (5) screen (length) 20 (depth to top) 70
- (size) 4/ (material) Plastic
- (6) pump 1/3 (HP) (yield gpm) 10
- (type power) Elec
- (7) electric log 70 (yes or no)

**CODED**

(organization running log)

(8) how well bottom plugged plugged

**DRILLERS REMARKS:**

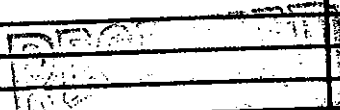

JUN 21 1974

MISS. BD OF WATER COMM