


ALL MEASUREMENTS TAKEN FROM (GROUND) (TOP OF CASING) (TOP OF BASE PLATE)

Drawing of the Well

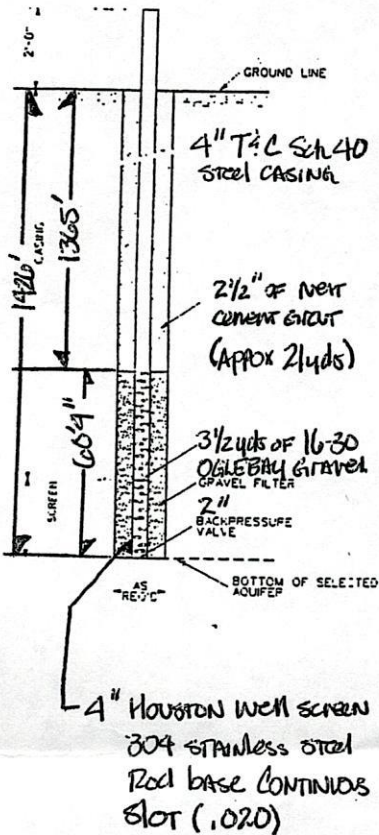

RECEIVED
SEP 03 2002
BY: OLWR

WELL DATA

STARTED WELL 5/23 2002 AND COMPLETED 6/13/ 2002
 TOTAL DEPTH 1426' ELEVATION _____ STATIC WATER LEVEL 131'
 LENGTH SURFACE CASING 45' SIZE 12" THICKNESS 250
 CEMENTED WITH 25 SACKS CEMENT TYPE PACKER N/A
 LENGTH WELL CASING 1365' SIZE 4" WEIGHT SMC40
 CEMENTED WITH 21 vds SACKS CEMENT TYPE PACKER N/A
 INNER CASING LENGTH N/A SIZE N/A WEIGHT N/A
 WITH N/A X N/A GUIDES LOCATED N/A TYPE BACKOFF N/A
 LEAD SEAL N/A BACKPRESSURE VALVE 2" GUIDE
 WELL STRAINER MAKE HOUSTON SS SIZE 4" LENGTH 60' 4" OPENING 20
 SLOT
 TYPE MATERIAL 304 STAINLESS WITH WR X WR CONNECTIONS
 SIZE HOLE DRILLED FOR SURFACE CASING 17" WITH ROCK ROLLER
 SIZE HOLE DRILLED FOR WELL CASING 9 7/8" WITH ROCK ROLLER
 SIZE HOLE DRILLED FOR STRAINER 9 7/8" WITH ROCK ROLLER
 YARDS OF GRAVEL USED 3 1/2 HOW PLACED GRAVEL LINE
 HOW WELL WAS DEVELOPED AIR DEVELOPMENT
 NOTES: Monitoring Well

PUMP RECORD

RIG USED GD2500 DRILLER Lynwood Hathcock
 SERIAL NUMBER _____ MAKE _____ FOUNDATION _____
 LENGTH COLUMN _____ SIZE _____ TYPE _____ • 10 LENGTHS
 BOWL SIZE _____ TYPE _____ STAGES _____ MATERIAL IMPELLOR
 MATERIAL BOWL _____ WITH _____ PORTS AND _____ SHAFT
 SUCTION SIZE _____ LENGTH _____ SUCTION STRAINER
 IS PUMP SEALED? HOW _____ WHERE _____ WITH WHAT _____
 LUBRICATOR TYPE _____ SIZE _____ VOLTAGE _____
 LENGTH OF AIRLINE _____ SIZE _____ VOLTAGE _____
 AIR RELEASE VALVE TYPE _____ SIZE _____
 SIZE SURFACE DISCHARGE _____ TYPE _____ DAYTON COUPLING
 PRESSURE GAUGE _____ SPEED _____
 NOTES: _____

RIG USED TO SET PUMP _____ INSTALLER _____
 DATE PUMP INSTALLED _____ 20 _____ DATE IN OPERATION _____ 20

MOTOR

MAKE _____ HP _____ FRAME _____
 PHASE _____ CYCLE _____ VOLT 220
 SPEED _____ MODEL _____ SERIAL NUMBER _____
 TOP BEARING _____ BOTTOM BEARING _____ RATCHET _____
 STARTER _____ PRESSURE SWITCH _____ FLOAT _____

GEAR

MAKE _____ MODEL _____ SIZE _____ RATIO _____ NO. _____
 SIZE PULLEY _____ TYPE MOTOR FRAME _____

ENGINE

MAKE _____ MODEL _____ HP _____ SERIAL NUMBER _____
 SPEED _____ SIZE PULLEY _____ FOUNDATION _____
 TYPE FUEL TANK _____ MAKE MAG. _____ NO. _____
 MAKE STARTER _____ NO. _____ TYPE FUEL _____
 MAKE FLEXIBLE SHAFT _____ SIZE _____
 LENGTH _____ BELT LENGTH _____

GENERAL

PURPOSE FOR WHICH THIS WATER IS USED Monitoring Well
 TEMPERATURE _____ IS WATER CLEAR _____ CAPACITY _____
 SAND _____ HARDNESS _____ PH _____ IRON _____ NACL _____
 TYPE TREATMENT USED _____
 IS THERE A DERRICK OVER THE WELL _____ HEIGHT _____ TYPE _____
 CAN TRUCK OR RIG EASILY GET TO WELL _____
 PUMP HOUSE _____ SIZE HATCH _____

CONTRACT NO. 57-5194

OUR WELL NO. 7 THEIR WELL NO. 7 IN TEST HOLE 1

LOCATION OF THE WELL Southaven, MS

INSTALLED FOR NEPCO Power Plant

ADDRESS CITY Southaven COUNTY Desoto STATE MS