	State Well Report	For Office Use Only:
County: Oesoto	Part 1 – Driller's Log	For Office Ose Omy.
	Mississippi Department of Environmental Quality	Aquifer:
Permit #: 6016288	Office of Land and Water Resources	Well #: 0 - 83
Driller: Jones w. Mason	P.O. Box 10631	weil #:
	Jackson, MS 39289-0631	L. S. Elevation:
Date drilling completed: 5-19-06	(601)961-5210	
	(601)354-6938 (fax)	E-log #:

State Law requires that this report be prepared by the license holder responsible for the work and filed with the Department at the above address within 30 days of completion of drilling of the well or borehole.

Information on Well Owner	Well or Borehole Location		
(Landowner if borehole is not for a water well)			
(Lunuowner if borenoie is not for a mater wear)	Latitude: 34 . 58 , 374" Longitude: 90 . 00 , 377"		
Owner Name Desoto County Schools	Method of Lat/Long (circle one): Conventional Survey,		
Mailing Address: Southous High School	USGS quad, (Hand-held GPS) Survey-grade GPS		
899 Rasco rd.	WE 1/ WE 1/4 Sec 26 Twn 15 Rng 8w		
Southover Ms 38671 City State Zip Code	SW NW 35		
	SW NW Joint Stance Distance Direction Nearest Town Miles E of H-y		
Telephone No. (662) 393- 9300			
Well / Bore	hole Data		
Date drilling started: $5 - 19 - 0C$ Date drilling completed: $5 - 19 - 0C$	Hole depth: 760 Hole diameter: 10		
Location of the source of any surface water used for drilling:			
Method of dosing and volume of Chlorine used in drilling and deve	lopment:		
Logs run (circle all applicable). No log run Electric Gamma Ray Name of organization running log(s):	Density Sonic Neutron Other:		
Purpose of borehole (check one): Water Well Geotechnical/Geological Investigation Ground Source Heat Pump			
Seismic SurveyOther (describe) If drilling is not related to water well construction, skip the remainder of this block			
Purpose of Well (check one): Home Industrial Public Suppl			
If a flowing well, method of flow regulation: Valve \mathcal{M}			
Static Water Level:			
Method of Measurement (circle one) steel tape electric tape air line other: <u>Strivel weight</u>			
Well depth: 360 Well grouted to a depth of 50 feet Type of grout (circle one): Neat Cemen Bentonite Mix			
Casing length: 300 feet Casing diameter: 6^{11} inches Type of casing: 900			
Screen length: <u>60</u> feet Screen diameter: <u>6</u> inches Type of screen: <u>poc</u>			
Screen slot size: ,010 inches Setting depth: From 200 feet to 260 feet			
Type of completion (circle all applicable): Gravel packed Under			
Other (describe):A`			
Top of lap pipe or reduction in casing:feet. If t	elescoped or more than one screen, describe on next page		
	Form: OLWR-SWR-1		

JUN 1 9 2006 BY: OLWR

BY: OLWR

The sketch below only required for water wells


If well telescopes, show depths on sketch. Ground Level

	Description of Formations Encountered	From (depth)	To (depth)
¥	Cley dert.	Ground Level	
	Giovel	56	30
	Blue clay	30	115
	while Soud	115	180
	white clay	180	190
	white soud	190	960
		·	
		<u></u>	
	· · · · · · · · · · · · · · · · · · ·		
			+

Description of formations encountered must be provided for all

wells and boreholes, unless specifically exempted by regulations

If more than one screen, show location of each on sketch

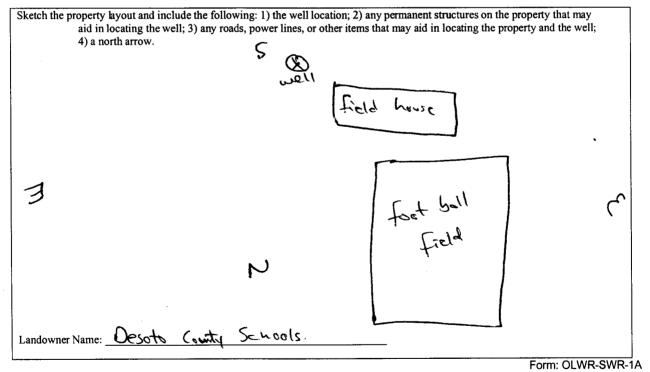

I certify that the well/borehole was drilled, constructed, and completed in accordance with all applicable requirements of the Mississippi Department of Environmental Quality and the Mississippi Department of Health regulations, if applicable, and state

laws. Tores w. Masor 0-670 6-13-06 Grow Mon RECEIVED Print Name of Responsible Licensee and License No. Date Signature of Licensee RECEIVED JUN 1 9 2006

	STATE WE	LL REPORT		
County: <u>Assolc</u> Permit #: <u>GW 16288</u> Driller: <u>Jers w Masso</u> Date completed: <u>6-10-06</u>	Part 2 Pump Installer's Completion Report Mississippi Department of Environmental Quality Office of Land and Water Resources P.O. Box 10631 Jackson, MS 39289-0631 (601)961-5210		For Office Use Only: Aquifer: Well #: <u>B - 83</u>	
Copy information from block on Part 1	(601)354-6938 (fax)		Elevation:	
This part of the report must be completed by a licensed water well contractor or a licensed pump installer. A copy of Part 1 of the report must be attached and both parts filed with the Department at the above address within 30 days of well completion. Well Owner Information Well Location				
Well Owner Information		Well Location		

Owner Name: <u>Desoto County Schools</u> Mailing Address: <u>Southous</u> High School	Latitude: 34.58, 274 Longitude: 70.00.377 22 Method of Lat/Long (check one): Conventional Survey,
899 Rosco (d	USGS quad, Hand-held GPS 🗹, Survey-grade GPS
Southousen Ms 38671 City State Zip Code	$\frac{\mathcal{WE}}{\mathcal{SW}} \stackrel{!}{{}} \stackrel{\mathcal{WE}}{{}} \stackrel{\mathcal{WE}}{} \stackrel{\mathcal{WE}}{\overset{\mathcal{WE}}} \stackrel{\mathcal{WE}}{} \stackrel{\mathcal{WE}}{\overset{\mathcal{WE}} \stackrel{\mathcal{WE}}{} \stackrel{\mathcal{WE}}{} \stackrel{\mathcal{WE}}{} \stackrel{\mathcal{WE}}{} \stackrel{\mathcal{WE}}{} \stackrel{\mathcal{WE}}{} \stackrel{\mathcal{WE}}{} \stackrel{\mathcal{WE}}{} \stackrel{\mathcal{WE}}{} \stackrel{\mathcal{WE}}{\overset{\mathcal{WE}} \stackrel{\mathcal{WE}}{\overset{\mathcal{WE}}} \stackrel{\mathcal{WE}}{\overset{\mathcal{WE}} \stackrel{\mathcal{WE}}{} \stackrel{\mathcal{WE}}{} \stackrel{\mathcal{WE}}{} \stackrel{\mathcal{WE}}{} \stackrel{\mathcal{WE}}{\overset{\mathcal{WE}} \stackrel{\mathcal{WE}}{\overset{\mathcal{WE}} \overset{\mathcal{WE}} \stackrel{\mathcal{WE}}{\overset{\mathcal{WE}} \stackrel{\mathcal{WE}} \stackrel{\mathcal{WE}}{\overset{\mathcal{WE}} \stackrel{\mathcal{WE}} \overset{\mathcal{WE}} \overset{\mathcal{WE}} \stackrel{\mathcal{WE}} \stackrel{\mathcal{WE}} \overset{\mathcal{WE}} \stackrel{\mathcal{WE}} \overset{\mathcal{WE}} \overset{\mathcal{WE} \overset{\mathcal{WE}} \overset{\mathcal{WE}} \overset{\mathcal{WE}} \overset{\mathcal{WE} $
Telephone No. (42) 393-9300	1/2 Miles E of Hay 51

Pump Type Circle one		Power Type Circle one			
Air Lift	Jet	Submersible	Diesel Engine	Gasoline Engine	Natural Gas
Bucket	Piston	Turbine (Electric Motor	Hand	Tractor PTO
Centrifugal	Rotary	Flowing Well	Windmill	Other (specify):	
Other (specify):			Horse Power Rating	g of Motor:	5 hp-
Date Pump Installed	6-10-0	°6	Setting Depth:	126	feet
Rated Pump Capacit	y: 150	Gallons Per Minute	Number of Stages:	6	

Pump Test Data	Method of Measuring Water Level Circle one	
Date Well Tested: $6 - 10 - 06$	Air Line Electric Measuring Line Steel Tape	
Static Water Level (A):Feet Below Land Surface Pumping Water Level (B):Feet Below Land Surface	Other (specify): <u>String</u> weight	
Drawdown [(B) – (A)]: \nearrow Feet Below Land Surface	For flowing well, measured shut in head:	
Test Pumping Rate: 150 Gallons Per Minute	Well yielded GPM with a drawdown of	
Duration of Pump Test (minimum 4 hours): <u> </u>	NA feet after $\underline{\partial 4}$ hours of pumping	

I HEREBY CERTIFY that the above statements are true to the best of	of my knowledge.	
Denes w. Masex. Print Name of Pump Installer and License No. (if applicable)	Signature of Pump Installer	
		JUN 192006

BY: OLWR