


B1997

DESOTO
~~B 0001~~

WATER WELL LOG

Date: 9-12-63 1963, Driller: E. B. Perry County Desala
9-12-63 (Name)

(1) Owner of Land:	Description & Color of Materials Sand, Clay, Red Clay, Shell, etc.	Thick- ness Feet	Depth Feet
<u>M. H. Lambert</u> (Name) <u>Horn Lake Miss</u> (Address)	0 to 30 <u>Clay</u>		
(2) Location: <u>1/4</u> , <u>1/4</u> , Sec. <u>13 T 3 R 6</u>	30 - 53 <u>muddy sand</u>		
<u>1 1/2</u> miles <u>West</u> of <u>Horn Lake</u> (distance) (direction) (Nearest Town)	53 - 89 <u>sand + gravel</u>		
(3) Topography: <u>Hilly</u> (Hilly) (Flat) (Level)	89 - 98 <u>yellow clay</u>		
(4) Purpose of Well: <u>To fill lake</u> (Domestic Irrigation Municipal, Industrial, Other)	98 - 218 <u>blue limst.</u>		
	218 - 233 <u>sandy limst.</u>		
	233 - 240 <u>very fine sand</u>		
	240 - 251 <u>limst.</u>		
	251 - 312 <u>sandy limst.</u>		
	312 - 321 <u>very fine sand</u>		
	321 - 327 <u>coarse med sand</u>		
	327 - 338 <u>coarse sand</u>		
	338 - 339 <u>lignite rotted wood</u>		
	339 - 347 <u>fine sand + lignite</u>		
	347 - 352 <u>med sand</u>		
	352 - 372 <u>coarse sand</u>		
Information upon completion of well:			
(1) Diameter <u>6</u> inches.			
(2) Total Depth <u>372</u> feet.			
(3) Water Level <u>71</u> feet below top of ground.			
(4) Cased to <u>357</u> , Size <u>6"</u>			
(5) Screen: Size <u>4" ID</u> , Length <u>15'</u>			
(6) Were any formations sealed against pollution? <u>X</u> yes, <u> </u> no.			
If YES depth of formation <u>clay puddle</u>			
Why <u>General practice</u>			
Drillers Remarks: <u>Did not drill to bottom of sand</u>			

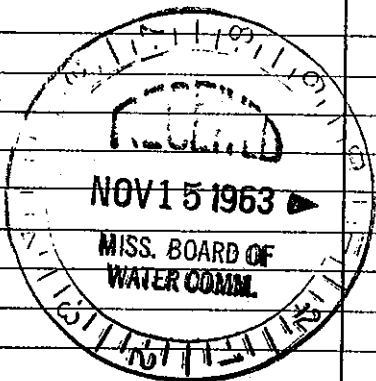

(Use Back Side)

Well No.

Retain this copy for your office files.