

**B1999**

DE SOTO MISSISSIPPI BOARD OF WATER COMMISSIONERS

~~B 0003~~

6-23-65

**WATER WELL DRILLERS LOG**

Date: June 23, 1965, Driller: Carloss Well Supply County De Soto

(Name)

	Description & Color of Materials Sand, Clay, Red Clay, Shell, etc.	Thick- ness Feet	Depth Feet
(1) Owner of Land: De Soto Utilities # 1 Office Park Plaza Southaven, Mississippi	Top Soil	40'	40'
Near Horn Lake, Miss.	Coarse Sand	10'	50'
(2) Location: 1/4, 1/4, Sec. T R,	Coarse Sand & Pea Grvl.	33'	83'
miles, of	Brown Shale & Lignite	13'	96'
(3) Topography: <u>Hilly</u>			
(4) Purpose of Well: <u>Subdivision</u>			


Information upon completion of well:

- (1) Diameter 6 inches.
- (2) Total Depth 83 feet.
- (3) Water Level 39' feet below top of ground.
- (4) Cased to 43', Size 6"
- (5) Screen: Size 6", Length 40'
- (6) Were any formations sealed against pollution?  
Casing Cemented  
yes, no.

If YES depth of formation \_\_\_\_\_

Why \_\_\_\_\_

Drillers Remarks: \_\_\_\_\_

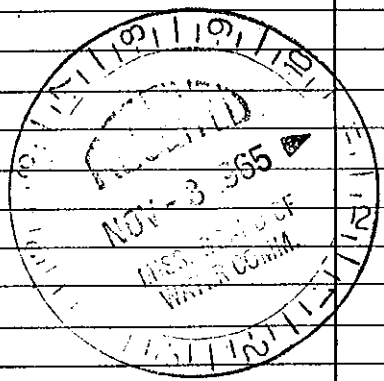

(Use Back Side)

Well No.

Mail this copy to Board of Water Commissioners 429 Miss. St. Jackson, Miss.