

De Soto

B 2002

MISSISSIPPI BOARD OF WATER COMMISSIONERS

3-13-62

WATER WELL DRILLERS LOG

Date: 3/13, 1962, Driller: Watson Co. County De Soto

(When well drilled)

(Name)

(Where well is located)

(1) Owner of Land: Baynes Farms  
(Name)  
Horn Lake, Miss.  
(Address)

(2) Location: 1/4, 1/4, Sec. T1 R8  
2 miles East of Horn Lake  
(distance) (direction) (Nearest Town)

(3) Topography: (Hilly) (Flat) (Level)

(4) Purpose of Well: Dairy  
(Domestic Irrigation, Municipal, Industrial, Other)

| Description & Color of Materials<br>Sand, Clay, Red Clay, Shell, etc. | Thick-<br>ness<br>Feet | Depth<br>Feet |
|---|------------------------|---------------|
| Clay  |                        | 22            |
| Sand + Gravel   |                        | 25            |
| Sandy Clay  |                        | 80            |
| Fine Sand & clay  |                        | 140           |
| Hard Sand   |                        | 245           |
| Fine Sand   |                        | 276           |
| Med-Coarse Sand   |                        | 305           |

Information upon completion of well:

- (1) Diameter 4 inches.
- (2) Total Depth 305'6" feet.
- (3) Water Level 116 feet below top of ground.
- (4) Cased to 283'6" Size #.015
- (5) Screen: Size, Length 22
- (6) Were any formations sealed against pollution?  
yes, no.

If YES depth of formation


Why

Drillers Remarks:

Yield in gpm:

Size pump: 13 Stage

Type power: 5 H.P.

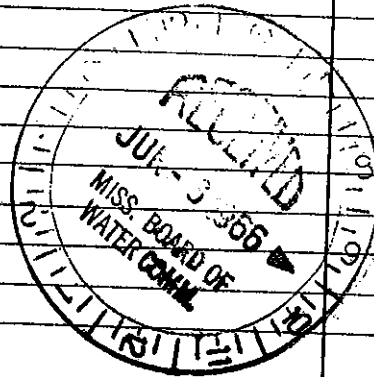

Mail this copy to Board of Water Commissioners 429 Miss. St. Jackson, Miss.