

DeSoto MISSISSIPPI BOARD OF WATER COMMISSIONERS


B 2004
7-12-63
WATER WELL DRILLERS LOG

Date: July 12, 1963, Driller: Deep South Well Co. County DeSoto
(Name)

	Description & Color of Materials Sand, Clay, Red Clay, Shell, etc.	Thick- ness Feet	Depth Feet
(1) Owner of Land: <u>Billy G. Wright</u> (Name)	0-30 surface clay	30	
<u>Horn Lake, Miss.</u> (Address)	30-45 Sand & Gravel	15	
(2) Location: <u>1/4, 1/4, Sec. T1 R8</u>	45-60 Yellow clay	15	
<u>1 1/2</u> miles <u>S.E.</u> of <u>Horn Lake</u> (distance) (direction) (Nearest Town)	60-176 Blue clay	116	
(3) Topography: <u>Flat</u> (Hilly) (Flat) (Level)	176-188 Med. sand	12	
(4) Purpose of Well: <u>Domestic</u> (Domestic Irrigation Municipal, Industrial, Other)	188-190 Fine sand	2	
	190-260 Blue clay	70	
	260-285 Fine sand	25	
	285-308 Coarse & med. coarse sand	23	

Information upon completion of well:

- (1) Diameter 2 1/2 inches.
- (2) Total Depth 308 feet.
- (3) Water Level 127 feet below top of ground.
- (4) Cased to None, Size _____
- (5) Screen: Size 1 1/2", Length 8 ft
- (6) Were any formations sealed against pollution?
_____ yes, no.

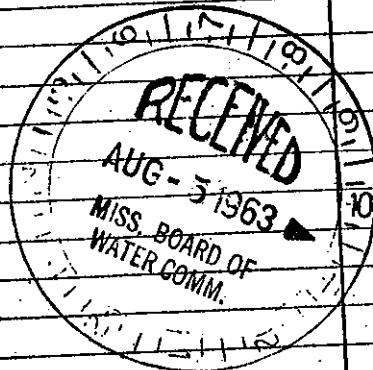

If YES depth of formation _____
Why _____
Drillers Remarks: _____

Well No.

(Use Back Side)

Mail this copy to Board of Water Commissioners 429 Miss. St. Jackson, Mis.