

DESOTO WATER WELL DRILLERS LOG

Date: B-12-24 2006, Driller: C B Perry County: Desoto  
(Name)

(1) Owner of Land:	Description & Color of Materials Sand, Clay, Red Clay, Shell, etc.	Thick- ness Feet	Depth Feet
Dealers auto <small>(Name)</small> Horn Lake Miss <small>(Address)</small>	050-18 ft Clay 18-38 med gravel-38- 210 270-270 fine sand-270-305 coarse sand		
(2) Location: <u>1/4</u> , <u>1/4</u> , Sec. <u>T1R8</u> , <u>1</u> miles <u>S-E</u> of <u>Horn Lake</u> <small>(distance) (direction) (Nearest Town)</small>			
(3) Topography: <input checked="" type="checkbox"/> (Hilly) <input type="checkbox"/> (Flat) <input type="checkbox"/> (Level)			
(4) Purpose of Well: <u>to serve business</u> <small>(Domestic Irrigation Municipal, Industrial, Other)</small>			


Information upon completion of well:

- (1) Diameter 3 inches.
- (2) Total Depth 305 feet.
- (3) Water Level 48 feet below top of ground.
- (4) Cased to 299, Size 3
- (5) Screen: Size 3", Length 6
- (6) Were any formations sealed against pollution?  
 yes,  no.

If YES depth of formation Clay Puddles

Why from surface around casing

Drillers Remarks:

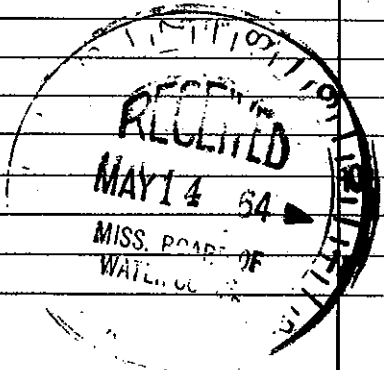

(Use Back Side)

Well No.

Retain this copy for your office files.