


DESOTO MISSISSIPPI BOARD OF WATER COMMISSIONERS

B 2007
2-15-66

WATER WELL DRILLERS LOG

Date: FEB. 15, 1966, Driller: MILLER County: DESOTO
(Name)

(1) Owner of Land:	Description & Color of Materials Sand, Clay, Red Clay, Shell, etc.	Thick- ness Feet	Depth Feet
(Name) ANDREW SAUSBERY	0-25 SURFACE CLAY	25	
(Address) RTE # 1 HORN LAKE, MISS	25-65 SAND + GRAVEL	40	
(2) Location: 1/4, 1/4, Sec. 20 T. 1 R. 8	65-81 YELLOW CLAY	16	
(3) Topography: 3 1/2 miles N.W. of HORN LAKE	81-330 BLUE CLAY	249	
(4) Purpose of Well: DOMESTIC	330-331 SOFT ROCK	1	
(5) Screen: Size 1 1/2", Length 8'	331-361 HARD LIGNITE	30	
(6) Were any formations sealed against pollution?	361-376 SAND + CLAY STR'S	15	
Information upon completion of well:	376-391 COARSE SAND	15	
(1) Diameter 2 1/2 inches.	MED. COARSE SAND	15	
(2) Total Depth 391 feet.			
(3) Water Level 150 feet below top of ground.			
(4) Cased to 384, Size 2 1/2			
(5) Screen: Size 1 1/2", Length 8'			
(6) Were any formations sealed against pollution? yes, <input checked="" type="checkbox"/> no.			
If YES depth of formation _____			
Why _____			
Drillers Remarks: _____			

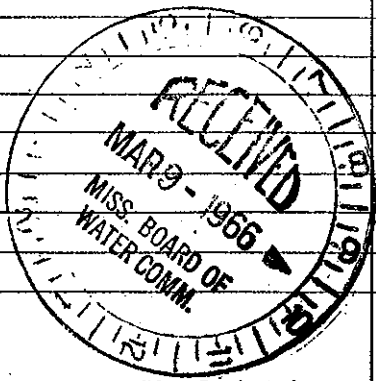

Well No.

Mail this copy to Board of Water Commissioners 429 Miss. St. Jackson, Miss