

Desoto

B 2008

5-66

MISSISSIPPI BOARD OF WATER COMMISSIONERS


WATER WELL DRILLERS LOG

Date: May, 1966, Driller: Harry Bros. County: Desoto  
(When well drilled) (Name) (Where well is located)

(1) Owner of Land: Bob Driver  
(Name)  
Horn Lake  
(Address)  
(2) Location: 1/4, 1/4, Sec. 22, 27, 36 T 6 R 8  
(distance) (direction) (Nearest Town)  
(3) Topography:  
(Hilly) (Flat) (Level)  
(4) Purpose of Well: Domestic  
(Domestic Irrigation  
Municipal, Industrial, Other)

Description & Color of Materials Sand, Clay, Red Clay, Shell, etc.	Thick- ness Feet	Depth Feet
top soil	0	20
sea gravel	20	60
grey clay	60	200
grey clay and sand	200	270
coarse white sand	270	300

Information upon completion of well:  
(1) Diameter 4 inches.  
(2) Total Depth 300 feet.  
(3) Water Level 120 feet below top of ground.  
(4) Cased to 286, Size 4"  
(5) Screen: Size 4", Length 14'  
(6) Were any formations sealed against pollution?  
yes, no.  
If YES depth of formation  
Why  
Drillers Remarks:  
Yield in gpm: 30  
Size pump: 1/2 motor  
Type power: electric

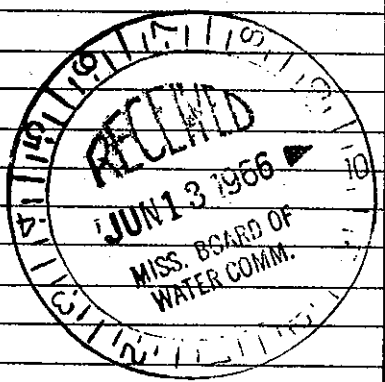

Mail this copy to Board of Water Commissioners 429 Miss. St. Jackson, Miss.