

MISSISSIPPI DEPARTMENT OF NATURAL RESOURCES

Bureau of Land and Water Resources

Southport Mall

P.O. Box 10631


Jackson, Mississippi 39209

WATER WELL DRILLERS LOG

DeSoto
B 2016

3-31-86 1986 Bullet Water Well DeSoto
date well completed firm name county well located

LANDOWNER:	description of formations encountered	from	to
Narry Siegman	top soil	0	2'
2265 Janyard Rd	Clay Rd	2'	21'
Herrando, Mo 38632	Gravel & sand	20'	70'
(mailing address)	White sand	70	120'
WELL LOCATION:			
sec <u>29</u> T <u>1</u> N R <u>8</u> E			
<u>5</u> miles <u>West</u> of <u>Southaven</u>			
(distance) (direction) (nearest town)			
WELL PURPOSE: <u>None</u>			
(home, irrigation, municipal, industrial)			
WELL COMPLETION DATA:			
(1) diameter (inches) <u>4"</u>			
(2) total depth (feet) <u>120'</u>			
(3) static water level (feet) <u>80'</u> below above top of ground.			
(4) casing <u>PVC</u> , <u>110'</u>			
(material) (depth)			
<u>4"</u> if telescope see back.			
(size)			
(5) screen <u>10'</u> , <u>110'</u>			
(length) (depth to top)			
<u>4"</u> , <u>PVC</u>			
(size) (material)			
(6) pump <u>2</u> , <u>10</u>			
(HP) (yield gpm)			
<u>Elec</u>			
(type power)			
(7) electric log <u>No</u>			
(yes or no)			
(organization running log)			
(8) how well bottom plugged <u>Cap</u>			
DRILLERS REMARKS:			

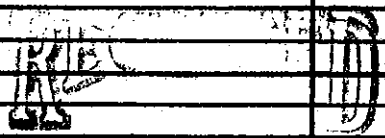

Department of Natural Resources
Bureau of Land & Water Resources