

Desoto

MISSISSIPPI BOARD OF WATER COMMISSIONERS

BC 11

WATER WELL DRILLERS LOG

9-9-61


CODED

Date: Sept. 9, 19 61, Driller: Deep South Well Co. County: Desoto

(Name)

	Description & Color of Materials Sand, Clay, Red Clay, Shell, etc.	Thick- ness Feet	Depth Feet
(1) Owner of Land: <u>Frank Rasco, Jr.</u> (Name) <u>Horn Lake, Miss.</u> (Address)	0-15 <u>Surface clay</u>	15	
	15-64 <u>Gravel &amp; sand</u>	49	
	64-68 <u>Yellow clay</u>	4	
(2) Location: <u>1/4</u> , <u>1/4</u> , Sec. <u>31 T.1 R.7</u> , <u>2 1/2</u> miles <u>East</u> , of <u>Horn Lake</u> (distance) (direction) (Nearest Town)	68-98 <u>Fine sand</u>	30	
	98-99 <u>Soft rock</u>	1	
	99-134 <u>Blue clay</u>	35	
(3) Topography: <u>Hilly</u> (Hilly) (Flat) (Level)	134-144 <u>Blue clay, sand</u>	10	
	144-187 <u>Sticky blue clay</u> <sup>strks</sup>	43	
(4) Purpose of Well: <u>Domestic</u> (Domestic Irrigation Municipal, Industrial, Other)	187-188 <u>Soft rock</u>	1	
	188-237 <u>Blue clay</u>	49	
	237-250 <u>Fine sand</u>	13	
	250-282 <u>Med. fine sand</u>	32	
	282-328 <u>Med. sand</u>	46	
	328-334 <u>Med. &amp; Med. coarse</u>	6	
Information upon completion of well:			
(1) Diameter <u>2 1/2</u> inches.			
(2) Total Depth <u>334</u> feet.			
(3) Water Level <u>105</u> feet below top of ground.			
(4) Cased to <u>None</u> , Size _____			
(5) Screen: Size <u>1 1/2"</u> , Length <u>8'</u>			
(6) Were any formations sealed against pollution? _____ yes, <u>No</u> no.			
If YES depth of formation _____			
Why _____			
Drillers Remarks: _____			
_____			
_____			
_____			

CODED

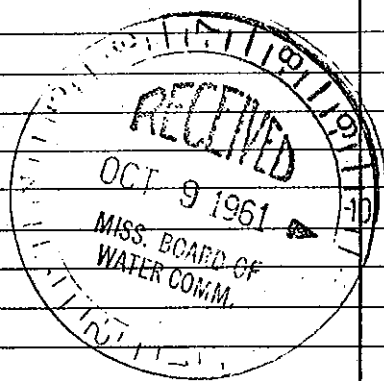

Well No.

(Use Back Side)

Mail this copy to Board of Water Commissioners 429 Miss. St. Jackson, Miss.