

C 12

10-19-63

WATER WELL DRILLERS LOG


CODED

Date: Oct. 19, 19 63, Driller: Deep South Well Co. County No.

(Name)

(1) Owner of Land: <u>Elmer Massey</u> (Name)	Description & Color of Materials Sand, Clay, Red Clay, Shell, etc.	Thick- ness Feet	Depth Feet
<u>Horn Lake, Miss.</u> (Address)	0-31 Surface clay	31	
(2) Location: <u>1/4, 1/4, Sec. 21, 26 T. 1 R. 7</u>	31-63 Sand & gravel	32	
<u>3</u> miles <u>N.E.</u> , of <u>Horn Lake</u> (distance) (direction) (Nearest Town)	63-120 Yellow sandy clay	57	
(3) Topography: <u>Hilly</u> (Hilly) (Flat) (Level)	120-147 Blue clay	27	
(4) Purpose of Well: <u>Domestic</u> (Domestic Irrigation Municipal, Industrial, Other)	147-148 Hard rock	1	
Information upon completion of well:	148-208 Sticky blue clay	60	
(1) Diameter <u>4</u> inches.	208-220 Sandy blue clay	12	
(2) Total Depth <u>310</u> feet.	220-260 Hard blue clay	40	
(3) Water Level <u>143</u> feet below top of ground.	260-261 Hard rock	1	
(4) Cased to <u>None</u> , Size _____	261-263 Blue clay	2	
(5) Screen: Size <u>2 1/2"</u> , Length <u>10 ft.</u>	263-264 Soft rock	1	
(6) Were any formations sealed against pollution? <u>no</u> yes, <u>no</u> no.	264-286 Sticky blue clay	22	
If YES depth of formation _____	286-287 Hard rock	1	
Why _____	287-294 Sandy blue clay	7	
Drillers Remarks: _____	294-310 Coarse & med. coarse sand	16	
_____			
_____			
CODED

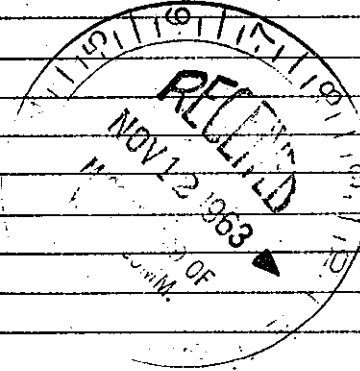

(Use Back Side)

Well No.