

527

State Well Report

Part 1

Mississippi Department of Environmental Quality
 Office of Land and Water Resources
 P.O. Box 10631
 Jackson, MS 39289-0631
 (601)961-5210
 (601)354-6938 (fax)

For Office Use Only:

Aquifer: _____
 Well #: C-29
 L. S. Elevation: _____
 E-log #: _____

County: DESOTO
 Permit #: Smith Well
 Driller: BOB SMITH
 Date drilling completed: 5-28-04

Drilling and Service

State Law requires that this report be prepared by the driller in detail and filed with the Department within 30 days of completion of drilling of the well.

Well Owner Information	Well Location
Owner Name: <u>DESOTO County Schools</u>	Latitude: _____ Longitude: _____
Mailing Address: _____	Method of Lat/Long (circle one): Conventional Survey, USGS quad, Hand-held GPS, Survey-grade GPS
<u>PLEASANT HILL RD.</u>	_____ 1/4 _____ 1/4 Sec <u>D-25</u> Twn <u>T1-S</u> Rng <u>R7-W</u>
<u>OLIVE BRANCH, MS</u>	Distance _____ Direction _____ Nearest Town _____
City _____ State _____ Zip Code _____	<u>5</u> Miles <u>NW</u> of <u>OLIVE BRANCH</u>
Telephone No. (____) _____	

Well Data

Purpose of Well (circle one) Home Industrial Public Supply Irrigation Fish Culture Other: _____

Date well drilling started: 5-28-04 Date well drilling completed: 5-29-04

If flowing, method of flow regulation: Valve _____ Other (describe) _____

Static Water Level: 191 feet above or below (circle one) land surface Date measured: 5-29-04

Method of Measurement (circle one) steel tape electric tape air line other: _____

Hole depth: 323 Well depth: 323 Well grouted to a depth of 32 feet

Type of grout (circle one): Cement Bentonite Mix

Casing length: 313 feet Casing diameter: 4 inches Type of casing: PVC

Screen length: 10 feet Screen diameter: 4 inches Type of screen: PVC

Screen slot size: 14 TWOS inches Setting depth: From 313 feet to 323 feet

Type of completion (circle all applicable): Gravel packed Underreamed Telescoped Open hole Natural Development
 Other (describe): WASHED SAND

Top of lap pipe or reduction in casing: _____ feet. If telescoped or more than one screen, describe on back of page

Logs run (circle all applicable): No log run Electric Gamma Ray Density Sonic Neutron Other: _____

Name of organization running log(s): _____

RECEIVED
 SEP 01 2004
 BY: OLWR

I certify that the well was drilled, constructed, and completed in accordance with all applicable requirements of the Mississippi Department of Environmental Quality and/or the Mississippi Department of Health regulations and state laws.

ROBERT C SMITH 0-645
 Print Name of Water Well Contractor and License No.

[Signature]
 Signature of Water Well Contractor

STATE WELL REPORT

Part 2

Pump Installer's Completion Report
 Mississippi Department of Environmental Quality
 Office of Land and Water Resources
 P.O. Box 10631
 Jackson, MS 39289-0631
 (601)961-5210
 (601)354-6938 (fax)

For Office Use Only:

Aquifer: _____

Well #: C-29

Elevation: _____

County: DESOTO
 Permit #: _____
 Driller: BOB SMITH
 Date completed: 7-30-04

This report should be prepared by the pump installer in detail and filed with the Department within 30 days of the installation of pump.

Well Owner Information	Well Location
Owner Name: <u>DESOTO County Schools</u>	Latitude: _____ Longitude: _____
Mailing Address: _____ <u>PLEASANT HILL RD.</u> <u>OLIVE BLANCH, MS.</u> City State Zip Code	Method of Lat/Long (circle one): Conventional Survey, USGS quad, Hand-held GPS, Survey-grade GPS _____ 1/4 _____ 1/4 Sec <u>D-25</u> Twn <u>T1-S</u> Rng <u>17-W</u>
Telephone No. (____) _____	Distance Direction Nearest Town <u>5</u> Miles <u>NW</u> of <u>OLIVE BLANCH</u>

Pump Type Circle one	Power Type Circle one
Air Lift Jet <input checked="" type="radio"/> <u>Submersible</u>	Diesel Engine Gasoline Engine <input checked="" type="radio"/> <u>Natural Gas</u>
Bucket Piston Turbine	<input checked="" type="radio"/> <u>Electric Motor</u> Hand
Centrifugal Rotary Flowing Well	Windmill Other (specify): _____
Other (specify): _____	Horse Power Rating of Motor: <u>7 1/2</u>
Date Pump Installed: <u>7-30-04</u>	Setting Depth: <u>230</u> feet
Rated Pump Capacity: <u>60</u> Gallons Per Minute	Number of Stages: <u>16</u>

RECEIVED
 SEP 06 2004
 BY: OLWR

Pump Test Data	Method of Measuring Water Level Circle one
Date Well Tested: <u>7-30-04</u>	Air Line <input checked="" type="radio"/> <u>Electric Measuring Line</u> Steel Tape
Static Water Level (A): <u>191</u> Feet Below Land Surface	Other (specify): _____
Pumping Water Level (B): <u>215</u> Feet Below Land Surface	For flowing well, measured shut in head: _____ feet
Drawdown [(B) - (A)]: <u>24</u> Feet Below Land Surface	Well yielded <u>93</u> GPM with a drawdown of
Test Pumping Rate: <u>9.3</u> Gallons Per Minute	<u>24</u> feet after <u>6</u> hours of pumping
Duration of Pump Test (minimum 4 hours): <u>6</u> hours	

I HEREBY CERTIFY that the above statements are true to the best of my knowledge.

ROBERT C SMITH # 0-645
 Print Name of Pump Installer and License No. (if applicable)

[Signature]
 Signature of Pump Installer

If well telescopes please sketch below and show depths.

Ground Level

C-29

Description of Formations Encountered	From	To
TOP SOIL	0	5
BROWN CLAY	5	30
GRAVEL	50	70
WHITE CLAY SAND	70	170
GREY CLAY	170	305
WHITE SAND	305	323


RECEIVED

If more than one screen, show location of each on sketch

SEP 01 2004

Sketch the property layout and include the following: 1) the well location; 2) any permanent structures on the property that may aid in locating the well; 3) any roads, power lines, or other items that may aid in locating the property and well; 4) indicate direction.


BY: OLWR

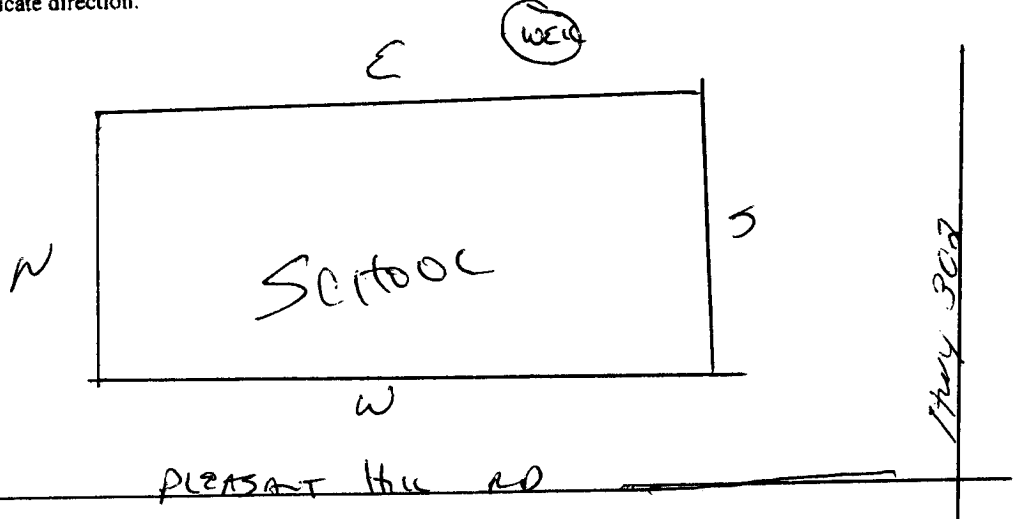

Landowner Name: DESOTO COUNTY SCHOOLS

[Signature]
Signature of Water Well Contractor

[Faint, illegible handwritten notes and markings, possibly bleed-through from the reverse side of the page.]

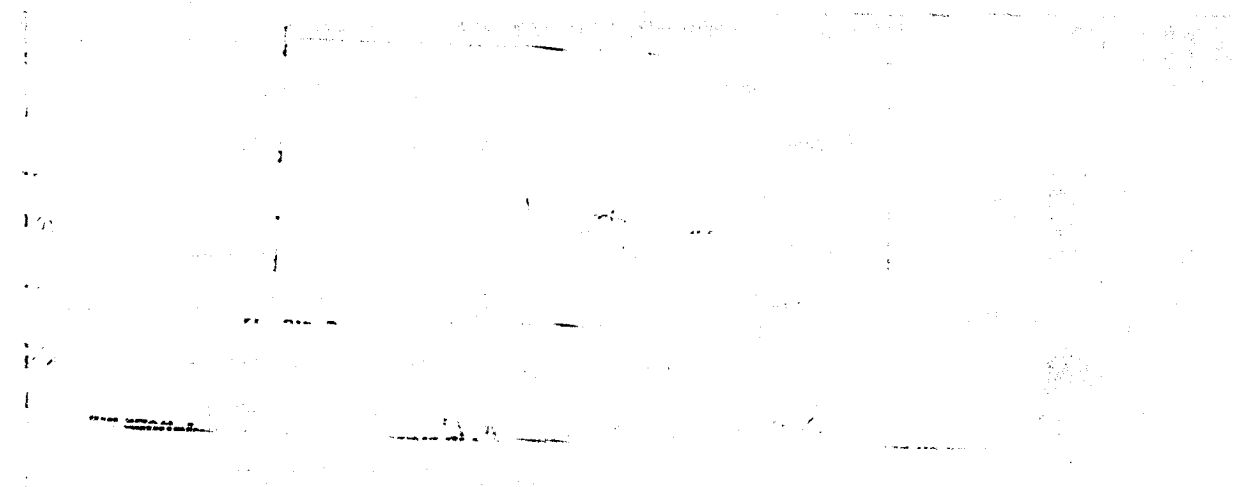

[Faint, illegible handwritten text or a signature.]

[Faint, illegible handwritten notes and markings, possibly bleed-through from the reverse side of the page.]