	State W	ell Report			
County: Desoto	Part 1 – Driller's Log		For Off The Only:		
	Mississippi Department of Environmental Quality		Aquifer:		
Permit #:	Office of Land and Water Resources		Well #:		
Driller: Jones W. Moson	P.O. Box 2309 Jackson, MS 39225				
Date drilling completed: 7-21-10	(601)9	961- 5210	L. S. Elevation:		
(601)96 ²		- 5228 (fax)	E-log #:		
State Law requires that this repor Department at the above address			he work and filed with the		
Information on Well Owner		Well or Bo	rehole Location		
(Landowner if borehole is not for a water well)		Latitude: 34 . 57 , 689 "Longitude: 89 . 53 , 083,"			
Owner Name South Mark		Latitude:	Longitude:		
Mailing Address: 5965 goodnow d		Method of Lat/Long (circle one): Conventional Survey,			
		USGS quad, Hand-held GPS, Survey-grade GPS			
		NE 1/2 NE 1/2 Sec 36 Twn 15 Rng 700			
Olive Brown N	15 38654.				
City State Zip Code		Distance Direction Nearest Town 3/4 Miles NE of pleasant will			
Telephone No. (901) 373 - 8799.		Miles of pleasant will			
	Well / Borel	iole Data			
Date drilling started: 7-14-10 Date drilling completed: 7-21-10 Hole depth: 350 Hole diameter: 5'					
Location of the source of any surface water used for drilling: NA Method of dosing and volume of Chlorine used in drilling and development:					
Lara way (simila all amplicable) Na lag wa	Electric Commo Day	Donaity Cania Nautron	Othor		
Logs run (circle all applicable): No log run Electric Gamma Ray Density Sonic Neutron Other:					
Purpose of borehole (check one): Water Well Geotechnical/Geological Investigation Ground Source Heat Pump					
Seismic Survey Other (describe) If drilling is not related to water well construction, skip the remainder of this block					
Purpose of Well (check one): Home Industrial Public Supply Irrigation Fish Culture Other:					
If a flowing well, method of flow regulation: Valve Other (describe)					
Static Water Level: feet above or below (circle one) land surface					
Method of Measurement (circle one) steel tape electric tape air line other:					
Well depth: Well grouted to a depth offeet Type of grout (circle one): Neat Cement Bentonite Mix					
Casing length:feet Casing diameter:inches Type of casing:					
Screen length:feet Screen	en diameter:	_inches Type of screen:			
Screen slot size:inches	Setting depth: From	feet to	feet		
Type of completion (circle all applicable): Gravel packed Underreamed Telescoped Open hole Natural Development					
Other (describe):					
Top of lap pipe or reduction in casing:feet. If telescoped or more than one screen, describe on next page					
Form: OLWR-SWR-1A (04/08)					

RECEIVED
AUG 1 1 2010


BY: OLWR

The sketch below only required for water wells

If well telescopes, show depths on sketch. Ground LevelDescription of formations encountered must be provided for all wells and boreholes, unless specifically exempted by regulations

Description of Formations Encountered		To (depth)
clay dict.	Ground Level	30
red soud	30	40
growel	40	60
Blue clay	60	145
white soud	145	250

If more than one screen, show location of each on sketch

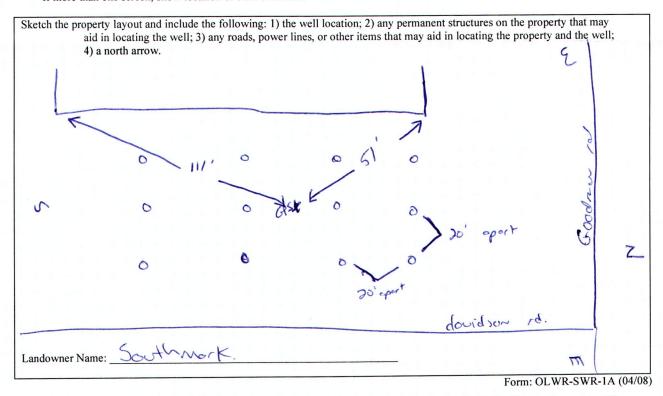

I certify that the well/borehole was drilled, constructed, and completed in accordance with all applicable requirements of the Mississippi Department of Environmental Quality and the Mississippi Department of Health regulations, if applicable, and state

laws. Jones W. Moson 0-620 Print Name of Responsible Licensee and License No.

Date

Signature of Licensee