

Desotas
D7
11-13-68

MISSISSIPPI
BOARD OF WATER COMMISSIONERS
416 North State Street
Jackson, Mississippi 39201

CODED

WATER WELL DRILLERS LOG

11-13-1968 date well completed
Nichelson Well, Co - firm name
Desotas county well located

LANDOWNER: Russell Djanne

description of formations encountered	from	to
Top Soil	0	10 FT
broken clay	10	30
clay	30	80
Sand & clay	80	110
Fine sand	110-140	
Coarse sand	140-156	

(mailing address)

WELL LOCATION:


sec 21 T. 1 N. R. 5 E. S. 5 W.
miles of (distance) (direction) (nearest town)

WELL PURPOSE: Home
(home, irrigation, municipal, industrial)

WELL COMPLETION DATA:

- (1) diameter (inches) 4 1/2
- (2) total depth (feet) 156
- (3) static water level (feet) 90 below top of ground.
- (4) casing (material) (depth) (size) If telescope see back.
- (5) screen 14 FT. (length) (depth to top) (size) (material) (yield gpm)
- (6) pump 220 (HP) (type power)
- (7) electric log No. (yes or no)

Well Located
Approx. 3/4 mile North East of Olive Branch MISS on Centerhill COBEE

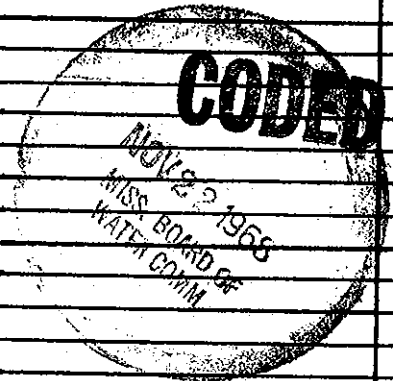

(organization running log)

well bottom plugged Solid Bottom

MARKS: None