

Desoto MISSISSIPPI BOARD OF WATER COMMISSIONERS

D22
9-65 *0250* WATER WELL DRILLERS LOG **CODED**

Date: 9-1-, 1965, Driller: Layne-Central Co. County Desoto

(Name)

Town of	Description & Color of Materials Sand, Clay, Red Clay, Shell, etc.	Thick- ness Feet	Depth Feet
(1) Owner of Land: <u>Mineral Wells</u> (Name)	clay	15	
<u>Mineral Wells, Mississippi</u> (Address)	fine gravel sand	10	25
(2) Location: <u>1/4</u> , <u>1/4</u> , Sec. <u>20 T1 R6</u>	tough white clay		90
<u>1</u> miles, of <u>1</u> miles (distance) (direction) (Nearest Town)	sandy clay		161
(3) Topography: _____ (Hilly) (Flat) (Level)	soft sandy clay	20	181
(4) Purpose of Well: <u>Municipal</u> (Domestic Irrigation, Municipal, Industrial, Other)	soft sandy clay	24	205
	soft muddy sand	22	227
	soft muddy sand	13	240
	pk sand	7	247
	pk sand	3	250
	pk sand	22	272

Information upon completion of well:

(1) Diameter 8" inches.

(2) Total Depth 279 feet.

(3) Water Level 90 feet below top of ground.

(4) Cased to 237', Size 8"

(5) Screen: Size 6", Length 35' 7"


(6) Were any formations sealed against pollution?
X yes, _____ no.

If YES depth of formation 237'

Why _____ required

Drillers Remarks: _____

CODED

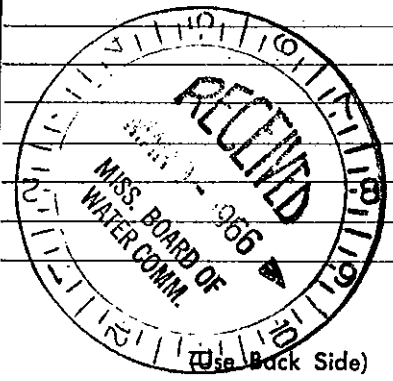

Well No.

Mail this copy to Board of Water Commissioners 429 Miss. St. Jackson, Miss.