

DESOTO
D 35

WATER WELL DRILLERS LOG

Date: 11-30-68, Driller: C.B. Perry
(Name)

CODED

(1) Owner of Land: Mr. Gobe
(Name)
Mineral Wells Miss
(Address)

(2) Location: 1/4, 1/4, Sec. 20 T1 R6
 Hwy 78 - 1 1/2 mi SW of Tenn
(distance) (direction) (Nearest Town)

(3) Topography: Hilly
(Hilly) (Flat) (Level)


(4) Purpose of Well: Domestic
(Domestic Irrigation
Municipal, Industrial, Other)

| Description & Color of Materials Sand, Clay, Red Clay, Shell, etc. | Thick- ness Feet | Depth Feet |
|---|------------------------|---------------|
| 0-11' Clay | | |
| 11-23' gravel | | |
| 23-35' Red sand | | |
| 35-43' yellow clay | | |
| 43-170' white clay | | |
| 170-200' fine sand | | |
| 200-228 coarse water sand | | |

CODED

Information upon completion of well:

- (1) Diameter 2 inches.
- (2) Total Depth 228 feet.
- (3) Water Level 119 feet below top of ground.
- (4) Cased to 224', Size 2"
- (5) Screen: Size 1 1/4", Length 4'
- (6) Were any formations sealed against pollution?
X yes, no.

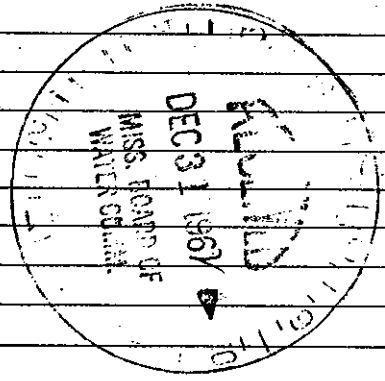

If YES depth of formation _____

Why Clay puddled from surface

Drillers Remarks: did not go to bottom of water sand

C. B. PERRY CO.
3102 SO. THIRD STREET,
MEMPHIS 9, TENNESSEE

Retain this copy for your office files.

(Use Back Side)

Well No.