

Desoto MISSISSIPPI BOARD OF WATER COMMISSIONERS

D 36

2-10-63

WATER WELL DRILLERS LOG

CODED

Date: 2/10, 19 63, Driller: Deep South Well Co. County DeSoto

(Name)

(1) Owner of Land: Cecil Stallings
(Name)

Rural Route, Olive Branch, Miss.
(Address)

(2) Location: 1/4, 1/4, Sec. 29T 1R 6

2 miles S.W. of Mineral Wells
(distance) (direction) (Nearest Town)

(3) Topography: Hilly
(Hilly) (Flat) (Level)

(4) Purpose of Well: Domestic
(Domestic Irrigation
Municipal, Industrial, Other)

Description & Color of Materials
Sand, Clay, Red Clay, Shell, etc.

Thick-
ness
Feet

Depth
Feet

0-30 Surface clay

30

30-45 Red sand & clay

15

45-65 Gravel & sand

20

65-160 Blue clay

95

160-193 Fine sand

33

193-209 Med. coarse
sand

16

CODED

Information upon completion of well:

(1) Diameter 2 1/2 inches.

(2) Total Depth 209 feet.

(3) Water Level 147 feet below top of ground.

(4) Cased to None, Size None

(5) Screen: Size 1 1/2", Length 8 ft.


(6) Were any formations sealed against pollution?

yes, No no.

If YES depth of formation

Why

Drillers Remarks:

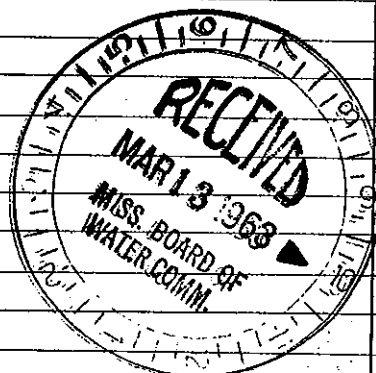

(Use Back Side)

Well No.

Mail this copy to Board of Water Commissioners 429 Miss. St. Jackson, Miss