

Desoto
D 38
7/66

Memph...
743-9702
743-2324

MISSISSIPPI BOARD OF WATER COMMISSIONERS

WATER WELL DRILLERS LOG

CODED

Date: 7-12, 1966, Driller: Watson Co. County: De Soto
(When well drilled) (Name) (Where well is located)

Heirigs

(1) Owner of Land: John J. Heirigs
(Name)

2224 Fremont - Memphis
(Address)

(2) Location: 1/4, 1/4, Sec. 34 T1 R6
in the town of Olive Branch
(distance) (direction) (Nearest Town)

(3) Topography: Level
(Hilly) (Flat) (Level)

(4) Purpose of Well: Industrial
(Domestic Irrigation Municipal, Industrial, Other)

Description & Color of Materials Sand, Clay, Red Clay, Shell, etc.	Thick- ness Feet	Depth Feet
Surface Clay		13
Drum		19
Sand		40
Lignite		41
Clay + Sand streaks		125
Fine Sand		176
Sand med. fine #1		196
✓ ✓ ✓ #2		216
✓ ✓ ✓ #3		235
✓ ✓ ✓ #4		241
Clay + Fine Sand		243

Information upon completion of well:

(1) Diameter 8" inches.

(2) Total Depth 243 feet.

(3) Water Level 103' 8" feet below top of ground.

(4) Cased to 211' 3", Size 8"

(5) Screen: Size .0124-.015, Length 31' 11"

(6) Were any formations sealed against pollution?

_____ yes, _____ no.

If YES depth of formation _____

Why _____


Drillers Remarks: _____

Yield in gpm: 560

Size pump: Submer

Type power: 25 H.P. + 30 H.P.

CODED

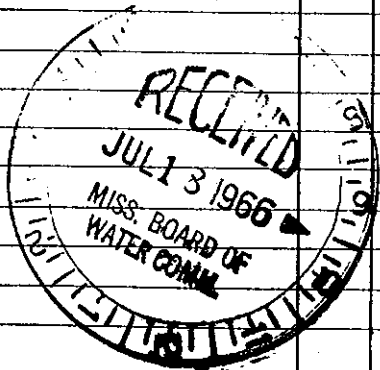

Mail this copy to Board of Water Commissioners 429 Miss. St. Jackson, Miss.