

De Soto
D 61
2-10-75


MISSISSIPPI
BOARD OF WATER COMMISSIONERS
416 North State Street
Jackson, Mississippi 39201

CODED

WATER WELL DRILLERS LOG

2-10-1975 W.R. Mason Well Co. De Soto
date well completed firm name county well located

LANDOWNER:	description of formations encountered	from	to
Eugene Durham Olive Branch Miss (mailing address)			
WELL LOCATION: sec. 21 T. 1 N. R. 6 E. 16R 1 1/2 miles N of Olive Branch (distance) (direction) (nearest town)	white clay	10	67
WELL PURPOSE: Home (home, irrigation, municipal, industrial)	blue clay	67	140
WELL COMPLETION DATA: (1) diameter (inches) 4" (2) total depth (feet) 198' (3) static water level (feet) 150' below top of ground. (4) casing Plastic, 178' (material) (depth) 4" (size) If telescope see back. (5) screen 20', 178' (length) (depth to top) 4" (size) Plastic (material) (6) pump 3/4 7 (HP) (yield gpm) electric (type power) (7) electric log No (yes or no) (organization running log) (8) how well bottom plugged Cap on screen	white sand	140	198

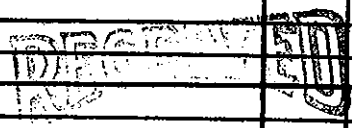

JUL 01 1975

DRILLERS REMARKS: