() Dent 1	Well Report	For Office Use Only:
	Part 1 – Driller's Log	
	Mississippi Department of Environmental Quality Office of Land and Water Resources	
	P.O. Box 10631	
Jackson.	MS 39289-0631	L. S. Elevation:
	(601)961-5210 (601)354-6938 (fax)	
(001).	554-0958 (Iax)	E-log #:
State Law requires that this report be prepared by the		
Department at the above address within 30 days of con Information on Well Owner		
(Landowner if borehole is not for a water well)	2	4
Dwner Name Louis Domiano	Latitude: 34 . 59 . 527	" Longitude: 89 . 44 , 669
Jwner Name	Method of Lat/Long (circle or	ne): Conventional Survey,
Mailing Address: 13875 conter drive		
Soddlebrook Jub.		GPS, Survey-grade GPS
	SE 1/4 SE 1/4 Sec 17	Twn S Rng Sw
City State Zip Code	Distance Direction	Nearest Town
	<u>J18</u> Miles <u>N</u>	of havdy corner
Telephone No. (101) 870 - 5339		
Well / Bo	orehole Data	
Date drilling started: $10 - 4 - 95$ Date drilling completed: $10 - 4$ Location of the source of any surface water used for drilling: Method of dosing and volume of Chlorine used in drilling and de		
Logs run (circle all applicable) No log run Electric Gamma R Name of organization running log(s):	ay Density Sonic Neutron	
Name of organization running log(s):		Other:
Purpose of borehole (check one): Water Well \checkmark Geotechnical/Geotechni	eological Investigation Ground	Other:
Name of organization running log(s):	cological Investigation Ground	Other:
Name of organization running log(s): A Purpose of borehole (check one): Water Well Geotechnical/Ge Seismic Survey Other (descr If drilling is not related to water_well construct	cological Investigation Ground ibe) tion, skip the remainder of this bl	Other:
Name of organization running log(s): A Purpose of borehole (check one): Water Well ∠ Geotechnical/Ge Seismic SurveyOther (descr If drilling is not related to water well construct Purpose of Well (check one): Home ∠ Industrial Public Sup If a flowing well, method of flow regulation: ValveA.	cological Investigation Ground <i>ibe</i>)	Other:
Name of organization running log(s): Geotechnical/Geotechnical	eological Investigation Ground <i>ibe</i>)	Other:
Purpose of borehole (check one): Water Well \checkmark Geotechnical/Geotechni	eological Investigation Ground <i>ibe</i>)	Other:
Name of organization running log(s): Geotechnical/Geotechnical	eological Investigation Ground <i>tibe</i>)	Other: Source Heat Pump ock Other: 10-10-05 ciws [weight hen Bentonite Mix
Name of organization running log(s):C Purpose of borehole (check one): Water Well Geotechnical/G	eological Investigation Ground <i>ibe</i>)	Other: I Source Heat Pump ock Other: 10-10-05 ciws [weight hen Bentonite Mix C
Name of organization running log(s): Geotechnical/	eological Investigation Ground <i>ibe</i>)	Other: I Source Heat Pump ock Other: 10-10-05 ciws [weight hen Bentonite Mix puc
Name of organization running log(s):Geotechnical/Geotechnical	eological Investigation Ground <i>tion, skip the remainder of this bl</i> plyIrrigation Fish Culture Other (describe) e) land surface Date measured: pe air line other: ype of grout (circle one): Neat Cen inches Type of casing: inches Type of screen:	Other: I Source Heat Pump ock Other: 10-10-05 ring [meight hen Bentonite Mix puc
Name of organization running log(s): Purpose of borehole (check one): Water Well Geotechnical/Geotechnical/Geotechnical/Geotechnical is not related to water well construct Purpose of Well (check one): Home Industrial Public Superior of Well (check one): Well grouted to a depth of Geotechnical (check one) is the lape Industrial	eological Investigation Ground <i>tion, skip the remainder of this bl</i> plyIrrigation Fish Culture Other (describe) e) land surface Date measured: pe air line other: pe of grout (circle one): Neat Cen inches Type of casing: inches Type of screen: hfeet to	Other: I Source Heat Pump ock Other: 10-10-05 ciws Iweight hen Bentonite Mix puc puc feet

Top of lap pipe or reduction in casing: _______ feet. If telescoped or more than one screen, describe on next page

Form: OLWR-SWR-1A

RECEIVED NOV 0 3 2005 BY: OLWR


D-110

The sketch below only required for water wells

If well telescopes, show depths on sketch. Ground Level Description of formations encountered must be provided for all wells and boreholes, unless specifically exempted by regulations

Clay dift.	From (depth) Ground Level	25
grovel	30	30
white clay	30	70
white soud	70	170

If more than one screen, show location of each on sketch

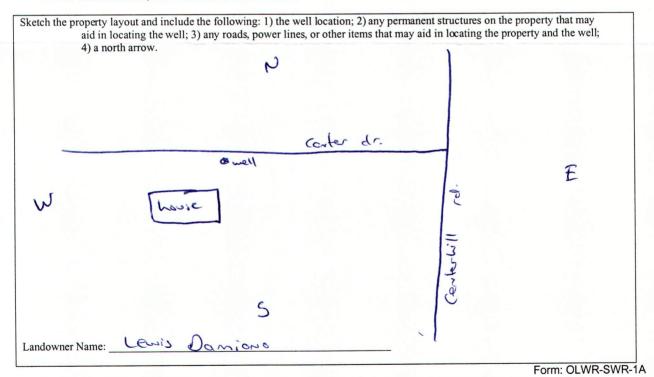

I certify that the well/borehole was drilled, constructed, and completed in accordance with all applicable requirements of the Mississippi Department of Environmental Quality and the Mississippi Department of Health regulations, if applicable, and state

(0-31-05

Date

laws. Jones w. Moson.

Jono w. Mon-

Print Name of Responsible Licensee and License No.

0-620

Signature of Licensee

NOV U 3 2005 BY: OLWR

	STATE WELL REPORT	
County: Desoto	Part 2 Pump Installer's Completion Report	For Office Use Only:
Permit #:	Mississippi Department of Environmental Quality	Aquifer:
Driller: Jores W. Moson	Office of Land and Water Resources P.O. Box 10631	n-110
Date completed: 10-10-05	Jackson, MS 39289-0631 (601)961-5210	Well #:
Copy information from block on Part 1	(601)354-6938 (fax)	Elevation:
This part of the report must be complet	ed by a licensed water well contractor or a licensed pump	installer. A copy of Part 1 of the

report must be attached and both parts filed with the Department at the above address within 30 days of well completion.		
Well Owner Information	Well Location	
Owner Name: Lewis Daniono	Latitude: 34.59,527 Longitude: 89,44.669	
Mailing Address: 13875 conter drive	Method of Lat/Long (check one): Conventional Survey,	
Soddlebrook Sub.	USGS quad, Hand-held GPS <u>/</u> , Survey-grade GPS	
Olivebrach MS 38654	<u>SE 1/2 SE 1/2 Sec 17 T 15 R Sw</u>	
City State Zip Code	Distance Direction Nearest Town	
Telephone No. (901) 870 - 5329	218 Miles N of handy corner	

Pump Type Circle one		Power Type Circle one			
Air Lift	Jet	Submersible	Diesel Engine	Gasoline Engine	Natural Gas
Bucket	Piston	Turbine	Electric Motor	Hand	Tractor PTO
Centrifugal	Rotary	Flowing Well	Windmill	Other (specify):	
Other (specify):	<u> </u>	in the second	Horse Power Rating	of Motor: $ ' _{2}$	
Date Pump Installed:	10-10-0	5	Setting Depth:	120	feet
Rated Pump Capacity:	18	Gallons Per Minute	Number of Stages:	14	_

Pump Test Data	Method of Measuring Water Level Circle one
Date Well Tested: $(0 - 10 - 05)$ Static Water Level (A): 75 Feet Below Land Surface Pumping Water Level (B): $p^{i}A$ Feet Below Land Surface	Air Line Electric Measuring Line Steel Tape Other (specify): <u>String (weight</u>
Drawdown [(B) – (A)]: $\swarrow A$ Feet Below Land Surface	For flowing well, measured shut in head: $\sim \sim \sim$ feet Well yielded (S GPM with a drawdown of
Test Pumping Rate: $(\& Gallons Per Minute Duration of Pump Test (minimum 4 hours): \rightarrow \neghours $	Well yielded <u>15</u> GPM with a drawdown of <u>NA</u> feet after <u>24</u> hours of pumping

I HEREBY CERTIFY that the above statements are true to the best of r	ny knowledge.	
T	G	
Print Name of Pump Installer and License No. (if applicable)	Signature of Pump Installer	
	<u>_</u>	Form: OLWR-SWR-1B
		neueiveu

NOV 0 3 2005 BY: OLWR