State Well Report				
County: Desoto	Part 1 – Driller's Log	For Office Use Only:		
Permit #:	Mississippi Department of Environmental Quality Office of Land and Water Resources	Aquifer:		
Driller: Jone, w. Mason	P.O. Box 10631 Jackson, MS 39289-0631	Well #:		
Date drilling completed: <u>2-16-06</u>	(601)961-5210 (601)354-6938 (fax)	E-log #:		

State Law requires that this report be prepared by the license holder responsible for the work and filed with the Department at the above address within 30 days of completion of drilling of the well or borehole.

Information on Well Owner	Well or Borehole Location			
(Landowner if borehole is not for a water well)				
Owner Name Shelio Perkins	Latitude: $34 \cdot 57 \cdot 997$ " Longitude: $89 \cdot 44 \cdot 404$ "			
Mailing Address: 14200 Johnson Cove	Method of Lat/Long (circle one): Conventional Survey, 24			
	USGS quad, Hand-held GPS, Survey-grade GPS			
	<u>500 1/2 Sw 1/2 Sec 28 Twn 15 Rng 500</u>			
Olive Brace MS 38654 City State Zip Code	Distance Direction Nearest Town			
	Distance Direction Nearest Town <u>118</u> Miles <u>of howdy (concerned)</u>			
Telephone No. (901) 428 0051				
Well / Borehole Data				
Date drilling started: $3 - 16 - 6$ Date drilling completed: $3 - 16 - 6$ Hole depth: 185 Hole diameter: $8''$				
Location of the source of any surface water used for drilling:				
Location of the source of any surface water used for drilling: A Method of dosing and volume of Chlorine used in drilling and development: A				
Logs run (circle all applicable): No log run Electric Gamma Ray Density Sonic Neutron Other:				
Purpose of borehole (check one): Water Well Geotechnical/Geological Investigation Ground Source Heat Pump				
Seismic SurveyOther (describe) If drilling is not related to water well construction, skip the remainder of this block				
Purpose of Well (check one): Home 🖌 Industrial Public Supply Irrigation Fish Culture Other:				
If a flowing well, method of flow regulation: Valve <u>NA</u> Other (describe)				
Static Water Level:feet above (rbelow)(circle one) land surface Date measured:				
Method of Measurement (circle one) steel tape electric tape air line other: String weight.				
Well depth: 185 Well grouted to a depth of 10 feet Type of grout (circle one): Neat Cement Bentonite Mix				
Casing length: 175 feet Casing diameter: 4 inches Type of casing: puc				
Screen length: 10 feet Screen diameter: 4 inches Type of screen: $\rho \circ c$				
Screen slot size: <u>010</u> inches Setting depth: From <u>175</u> feet to <u>185</u> feet				
Type of completion (circle all applicable): Gravel packed Underreamed Telescoped Open hole Natural Development				
Other (describe):				
Top of lap pipe or reduction in casing: NA feet. If telescoped or more than one screen, describe on next page				
	Eorm: OI WR-SWR-1A			

RECEIVED MAR 2 1 2006 BY: OLWR

D-115


The sketch below only required for water wells

If well telescopes, show depths on sketch. Ground Level_

Description of formations encountered must be provided for all wells and boreholes, unless specifically exempted by regulations

Description of Formations Encountered	From (depth)	To (depth)
Clay dit.	Ground Level	10
Red Soud	10	30
grovel	30	45
white clay	45	60
white soud	60	90
white clay	90	95
white sond	- 95	185
		1
		1
		<u> </u>

If more than one screen, show location of each on sketch

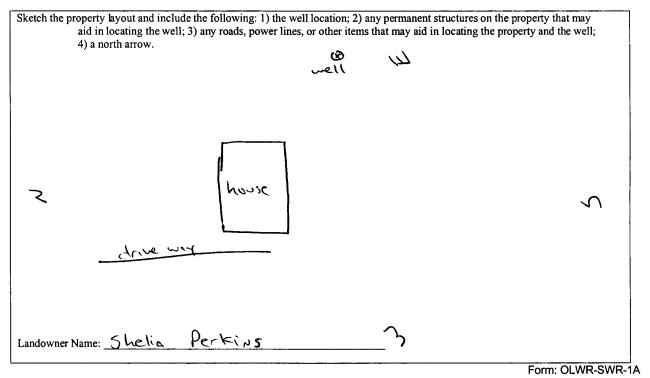

I certify that the well/borehole was drilled, constructed, and completed in accordance with all applicable requirements of the Mississippi Department of Environmental Quality and the Mississippi Department of Health regulations, if applicable, and state

Date

laws. Jones W Mosce 0-620 3-14-06

Jans MAR 2 1 2006 BY: OLWR

Print Name of Responsible Licensee and License No.

STATE WELL REPORT				
Permit #:	For Office Use Only:s Completion Report nt of Environmental Quality and Water Resources Box 10631 MS 39289-0631)961-5210 54-6938 (fax)For Office Use Only: Aquifer: Well #: $D - 1/5$ Elevation: Elevation: Elevation: Well #: $D - 1/5$ Elevation: Elevation: Well #: $D - 1/5$ Elevation: Elevation: Well #: $D - 1/5$ Elevation: Elevation: Mell days of well completion.Well #: $D - 1/5$ Elevation: Elevation: Elevation: D - 1/5Vell Location Vell Location Latitude: $34.57.997$ Longitude: $89.44.494.57$ Method of Lat/Long (check one): Conventional Survey_,			
Mailing Address: 14200 Johnson Core Once Brown M3 38654 City State Zip Code Telephone No. (901) 428 0051	Method of Lat/Long (check one): Conventional Survey, USGS quad, Hand-held GPS, Survey-grade GPS <u>5w 1/4 5w 1/4 Sec 28 T LS R 5w</u> Distance Direction Nearest Town <u>'18 Miles N of Laway Cornect</u>			
Pump Type Circle one Air Lift Jet Submersible Bucket Piston Turbine Centrifugal Rotary Flowing Well Other (specify):	Power Type Circle one Diesel Engine Gasoline Engine Natural Gas Diesel Engine Gasoline Engine Natural Gas Electric Motor Hand Tractor PTO Windmill Other (specify):			
Pump Test Data Date Well Tested: $\bigcirc - \partial \partial - \partial \delta$ Static Water Level (A): $\bigcirc G$ Feet Below Land Surface Pumping Water Level (B): $\lor A$ Feet Below Land Surface Drawdown [(B) - (A)]: $\lor A$ Feet Below Land Surface Test Pumping Rate: (\circlearrowright Gallons Per Minute Duration of Pump Test (minimum 4 hours): $\bigcirc \bigcirc \bigcirc$ hours I HEREBY CERTIFY that the above statements are true to the best of	Method of Measuring Water Level Circle one Air Line Electric Measuring Line Steel Tape Other (specify): $_{\underline{Striws}}$ (weight For flowing well, measured shut in head: \mathcal{NA} feet Well yielded 12 GPM with a drawdown of \mathcal{NA} feet after $\overline{\mathcal{YA}}$ hours of pumping of my knowledge.			
Janes W. M. Son. Print Name of Pump Installer and License No. (if applicable)	Gens un Man Signature of Pump Installer RECEIVE			

Jenes W. M. Ser. Print Name of Pump Installer and License No. (if applicable)

ForRECENTED MAR 2 1 2006 BY: OLWR