

State Well Report

Part 1 - Driller's Log

Mississippi Department of Environmental Quality
Office of Land and Water Resources
P.O. Box 10631
Jackson, MS 39289-0631
(601)961-5210
(601)354-6938 (fax)

County: Desoto
Permit #: GW16283
Driller: Jones w Masor
Date drilling completed: 3-5-06

For Office Use Only:
Aquifer: _____
Well #: D-117
L. S. Elevation: _____
E-log #: _____

State Law requires that this report be prepared by the license holder responsible for the work and filed with the Department at the above address within 30 days of completion of drilling of the well or borehole.

Information on Well Owner (Landowner if borehole is not for a water well)	Well or Borehole Location
Owner Name: <u>Inman Construction / Desoto County Schools</u>	Latitude: <u>34° 59' 181"</u> Longitude: <u>89° 45' 344"</u>
Mailing Address: <u>Looney rd.</u>	Method of Lat/Long (circle one): <u>11</u> Conventional Survey, <u>20</u>
<u>Desoto East Middle / High school</u>	USGS quad, <u>(Hand-held GPS)</u> Survey-grade GPS
<u>olive Branch</u> MS <u>38654</u>	<u>SW</u> 1/4 <u>NE</u> 1/4 Sec <u>20</u> Twn <u>15</u> Rng <u>5w</u>
City State Zip Code	Distance <u>1 7/8</u> Miles Direction <u>NW</u> of <u>handy corner</u>
Telephone No. <u>(901) 682-4100</u>	

Well / Borehole Data

Date drilling started: 3-5-06 Date drilling completed: 3-5-06 Hole depth: 260 Hole diameter: 10"

Location of the source of any surface water used for drilling: NA

Method of dosing and volume of Chlorine used in drilling and development: NA

Logs run (circle all applicable): No log run Electric Gamma Ray Density Sonic Neutron Other: _____

Name of organization running log(s): NA

Purpose of borehole (check one): Water Well Geotechnical/Geological Investigation _____ Ground Source Heat Pump _____

Seismic Survey _____ Other (describe) NA

If drilling is not related to water well construction, skip the remainder of this block

Purpose of Well (check one): Home _____ Industrial _____ Public Supply _____ Irrigation Fish Culture _____ Other: _____

If a flowing well, method of flow regulation: Valve NA Other (describe) _____

Static Water Level: 75 feet above or below (circle one) land surface Date measured: 3-5-06

Method of Measurement (circle one) steel tape electric tape air line other: string / weight

Well depth: 260 Well grouted to a depth of 50 feet Type of grout (circle one): Neat Cement Bentonite Mix

Casing length: 200 feet Casing diameter: 6 inches Type of casing: pvc

Screen length: 60 feet Screen diameter: 6 inches Type of screen: pvc

Screen slot size: 013 inches Setting depth: From 200 feet to 260 feet

Type of completion (circle all applicable): Gravel packed Underreamed Telescoped Open hole Natural Development

Other (describe): _____

Top of lap pipe or reduction in casing: NA feet. **If telescoped or more than one screen, describe on next page**

Form: OLWR-SWR-1A

RECEIVED

APR 10 2006

BY: OLWR

D-117

The sketch below only required for water wells

If well telescopes, show depths on sketch.


Ground Level →

Description of formations encountered must be provided for all wells and boreholes, unless specifically exempted by regulations

Description of Formations Encountered	From (depth)	To (depth)
clay dirt	Ground Level	30
white clay	30	50
white sand	50	70
white clay	70	75
white sand	75	130
white clay	130	170
white sand	170	260

If more than one screen, show location of each on sketch

Sketch the property layout and include the following: 1) the well location; 2) any permanent structures on the property that may aid in locating the well; 3) any roads, power lines, or other items that may aid in locating the property and the well; 4) a north arrow.

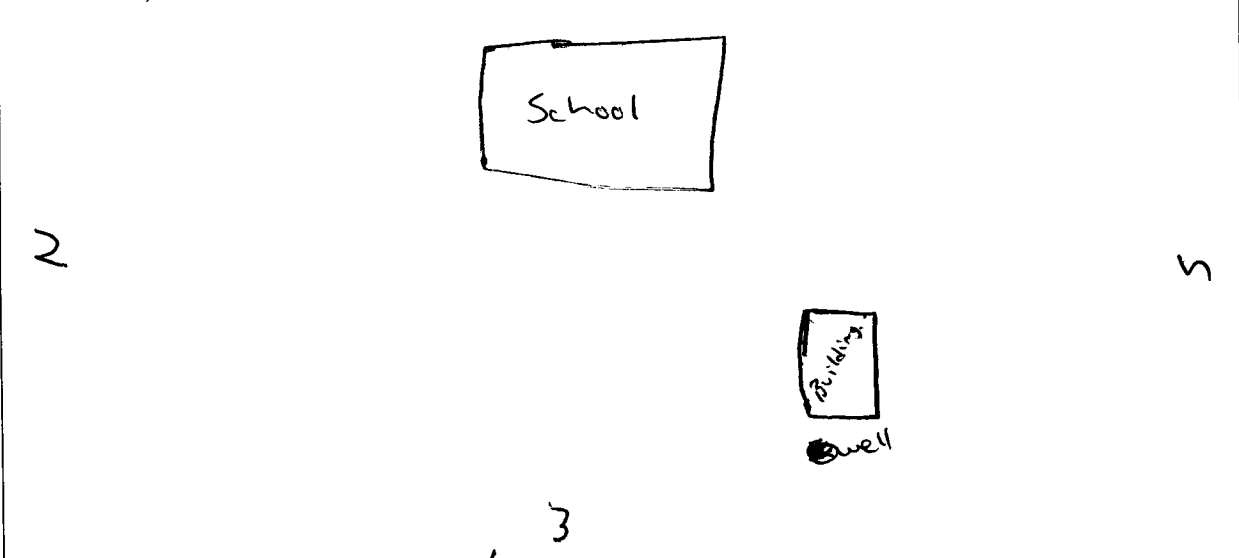

Landowner Name: Inman Construction / DeSoto County Schools.

Form: OLWR-SWR-1A

I certify that the well/borehole was drilled, constructed, and completed in accordance with all applicable requirements of the Mississippi Department of Environmental Quality and the Mississippi Department of Health regulations, if applicable, and state laws.

Jones W. Mason 0-620
Print Name of Responsible Licensee and License No.

4-4-06
Date

Jones W. Mason
Signature of Licensee

RECEIVED
APR 10 2006
BY: OLWR

STATE WELL REPORT

Part 2

Pump Installer's Completion Report
 Mississippi Department of Environmental Quality
 Office of Land and Water Resources
 P.O. Box 10631
 Jackson, MS 39289-0631
 (601)961-5210
 (601)354-6938 (fax)

County: Desoto
 Permit #: _____
 Driller: James W. Mason
 Date completed: 3-26-06
Copy information from block on Part 1

For Office Use Only:

Aquifer: _____
 Well #: D-117
 Elevation: _____

This part of the report must be completed by a licensed water well contractor or a licensed pump installer. A copy of Part 1 of the report must be attached and both parts filed with the Department at the above address within 30 days of well completion.

Well Owner Information	Well Location
Owner Name: <u>Inman Construction / Desoto County Schools</u>	Latitude: <u>34.59.181</u> Longitude: <u>89.45.344</u>
Mailing Address: <u>Looney rd.</u>	Method of Lat/Long (check one): Conventional Survey <u>11</u>
<u>Desoto East middle / High School</u>	USGS quad _____, Hand-held GPS <input checked="" type="checkbox"/> , Survey-grade GPS _____
<u>Olive Branch MS 38654</u>	NW <u>1</u> / <u>4</u> NE <u>1</u> / <u>4</u> Sec <u>20</u> T <u>15</u> R <u>5w</u>
City State Zip Code	Distance Direction Nearest Town
Telephone No. (901) <u>682-4100</u>	<u>17/8</u> Miles <u>NW</u> of <u>handy corner</u>

Pump Type Circle one	Power Type Circle one
Air Lift Jet <input type="checkbox"/> Submersible <input checked="" type="checkbox"/>	Diesel Engine Gasoline Engine Natural Gas
Bucket Piston Turbine	Electric Motor <input checked="" type="checkbox"/> Hand Tractor PTO
Centrifugal Rotary Flowing Well	Windmill Other (specify): _____
Other (specify): _____	Horse Power Rating of Motor: <u>15 hp</u>
Date Pump Installed: <u>3-26-06</u>	Setting Depth: <u>126'</u> feet
Rated Pump Capacity: <u>150</u> Gallons Per Minute	Number of Stages: <u>6</u>

Pump Test Data	Method of Measuring Water Level Circle one
Date Well Tested: <u>NO power at location</u>	Air Line Electric Measuring Line Steel Tape
Static Water Level (A): <u>75</u> Feet Below Land Surface	Other (specify): <u>string / weight</u>
Pumping Water Level (B): <u>NA</u> Feet Below Land Surface	<u>NO power at location</u>
Drawdown [(B) - (A)]: <u>NA</u> Feet Below Land Surface	For flowing well, measured shut in head: <u>NA</u> feet
Test Pumping Rate: <u>NA</u> Gallons Per Minute	Well yielded <u>NA</u> GPM with a drawdown of
Duration of Pump Test (minimum 4 hours): <u>NA</u> hours	<u>NA</u> feet after <u>NA</u> hours of pumping

I HEREBY CERTIFY that the above statements are true to the best of my knowledge.

James W. Mason James W. Mason
 Print Name of Pump Installer and License No. (if applicable) Signature of Pump Installer

Form: OLWFSWRE1B
RECEIVED
 APR 18 2006
 BY: OLWR