

State Well Report

Part 1 - Driller's Log

Mississippi Department of Environmental Quality
Office of Land and Water Resources
P.O. Box 10631
Jackson, MS 39289-0631
(601)961-5210
(601)354-6938 (fax)

County: Oesoto
 Permit #: GW 16285
 Driller: Jones w. Mason
 Date drilling completed: 3-12-06

For Office Use Only:

Aquifer: _____
 Well #: D-119
 L. S. Elevation: _____
 E-log #: _____

State Law requires that this report be prepared by the license holder responsible for the work and filed with the Department at the above address within 30 days of completion of drilling of the well or borehole.

Information on Well Owner <i>(Landowner if borehole is not for a water well)</i>	Well or Borehole Location
Owner Name: <u>Inman Construction / Oesoto County Schools</u> Mailing Address: <u>Looney rd.</u> <u>Oesoto East Middle / High School</u> <u>Olive Branch MS 38654.</u> City State Zip Code Telephone No. (901) <u>682-4100</u>	Latitude: <u>34° 59' 39.8"</u> Longitude: <u>89° 45' 17.1"</u> Method of Lat/Long (circle one): <u>24</u> Conventional Survey, <u>10</u> USGS quad, <u>(Hand-held GPS)</u> Survey-grade GPS <u>NW</u> 1/4 <u>NE</u> 1/4 Sec <u>20</u> Twn <u>15</u> Rng <u>5w</u> NE NW Distance Direction Nearest Town <u>1 7/8</u> Miles <u>NW</u> of <u>handy corner</u>
Well / Borehole Data	
Date drilling started: <u>3-12-06</u> Date drilling completed: <u>3-12-06</u> Hole depth: <u>250'</u> Hole diameter: 10"	
Location of the source of any surface water used for drilling: <u>NA</u> Method of dosing and volume of Chlorine used in drilling and development: <u>NA</u>	
Logs run (circle all applicable) <u>(No log run)</u> Electric Gamma Ray Density Sonic Neutron Other: _____ Name of organization running log(s): <u>NA</u>	
Purpose of borehole (check one): Water Well <input type="checkbox"/> Geotechnical/Geological Investigation <input checked="" type="checkbox"/> Ground Source Heat Pump _____ Seismic Survey _____ Other (describe) _____	
<i>If drilling is not related to water well construction, skip the remainder of this block</i>	
Purpose of Well (check one): Home _____ Industrial _____ Public Supply _____ Irrigation <input checked="" type="checkbox"/> Fish Culture _____ Other: _____	
If a flowing well, method of flow regulation: Valve <u>NA</u> Other (describe) _____	
Static Water Level: <u>75</u> feet above or below (circle one) land surface Date measured: <u>3-12-06</u>	
Method of Measurement (circle one) steel tape electric tape air line other: <u>String / weight</u>	
Well depth: <u>250</u> Well grouted to a depth of <u>50</u> feet Type of grout (circle one): Neat Cement <u>(Bentonite)</u> Mix	
Casing length: <u>190</u> feet Casing diameter: <u>6</u> inches Type of casing: <u>pvc</u>	
Screen length: <u>60</u> feet Screen diameter: <u>6</u> inches Type of screen: <u>pvc</u>	
Screen slot size: <u>.010</u> inches Setting depth: From <u>190</u> feet to <u>250</u> feet	
Type of completion (circle all applicable): <u>(Gravel packed)</u> Underreamed Telescoped Open hole Natural Development Other (describe): <u>NA</u>	
Top of lap pipe or reduction in casing: <u>NA</u> feet. <i>If telescoped or more than one screen, describe on next page</i>	

Form: OLWR-SWR-1A

RECEIVED


APR 10 2006

BY: OLWR

D-119

The sketch below only required for water wells

If well telescopes, show depths on sketch.

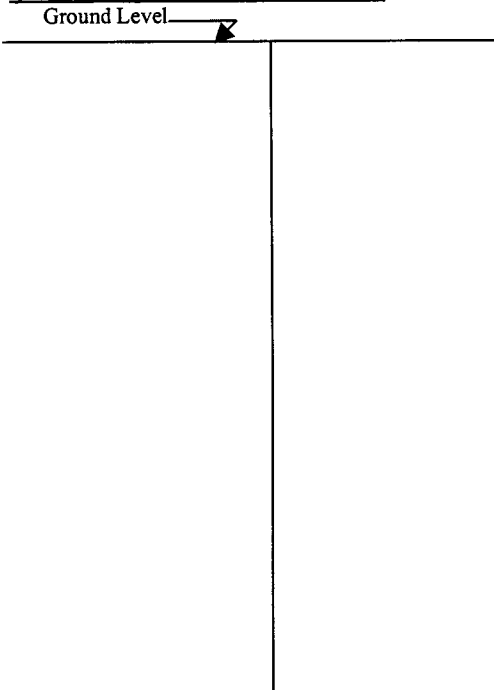


Description of formations encountered must be provided for all wells and boreholes, unless specifically exempted by regulations

Description of Formations Encountered	From (depth)	To (depth)
Clay dirt	Ground Level	30
White sand	30	65
White clay	65	75
White sand	75	250

If more than one screen, show location of each on sketch

Sketch the property layout and include the following: 1) the well location; 2) any permanent structures on the property that may aid in locating the well; 3) any roads, power lines, or other items that may aid in locating the property and the well; 4) a north arrow.

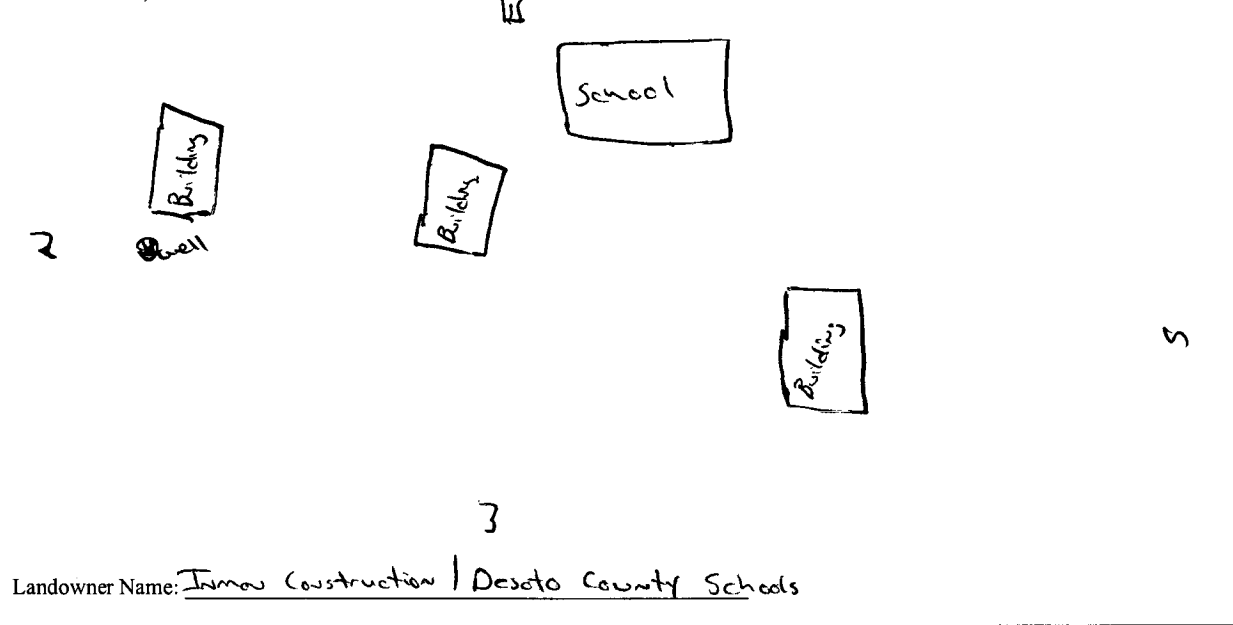

Form: OLWR-SWR-1A

I certify that the well/borehole was drilled, constructed, and completed in accordance with all applicable requirements of the Mississippi Department of Environmental Quality and the Mississippi Department of Health regulations, if applicable, and state laws.

James W. Masow 0-620 4-4-06

Print Name of Responsible Licensee and License No.

Date

Signature of Licensee

RECEIVED

APR 10 2006
BY: OLWR

STATE WELL REPORT

Part 2

Pump Installer's Completion Report
 Mississippi Department of Environmental Quality
 Office of Land and Water Resources
 P.O. Box 10631
 Jackson, MS 39289-0631
 (601)961-5210
 (601)354-6938 (fax)

County: Oesato
 Permit #: _____
 Driller: Jones w Masow
 Date completed: 3-26-06
Copy information from block on Part 1

For Office Use Only:

Aquifer: _____
 Well #: D-119
 Elevation: _____

This part of the report must be completed by a licensed water well contractor or a licensed pump installer. A copy of Part 1 of the report must be attached and both parts filed with the Department at the above address within 30 days of well completion.

Well Owner Information	Well Location
Owner Name: <u>Inman Construction / Oesato County Schools</u>	Latitude: <u>34.59.398</u> Longitude: <u>89.45.171</u>
Mailing Address: <u>Looney rd</u> <u>Oesato East Middle / High School</u>	Method of Lat/Long (check one): Conventional Survey _____, USGS quad _____, Hand-held GPS <input checked="" type="checkbox"/> , Survey-grade GPS _____
<u>Olive Branch ms 38654</u> City State Zip Code	<u>NW 1/4 NE 1/4 Sec 20 T 15 R 5w</u>
Telephone No. <u>(901) 682-4100</u>	Distance Direction Nearest Town <u>178 Miles NW of handy corner</u>

Pump Type Circle one	Power Type Circle one
Air Lift Jet <input type="checkbox"/> Submersible <input checked="" type="checkbox"/>	Diesel Engine Gasoline Engine Natural Gas
Bucket Piston Turbine	Electric Motor Hand Tractor PTO
Centrifugal Rotary Flowing Well	Windmill Other (specify): _____
Other (specify): _____	Horse Power Rating of Motor: <u>15</u>
Date Pump Installed: <u>3-26-06</u>	Setting Depth: <u>126</u> feet
Rated Pump Capacity: <u>150</u> Gallons Per Minute	Number of Stages: <u>6</u>

Pump Test Data	Method of Measuring Water Level
Date Well Tested: <u>NA</u> <i>no power at location</i>	Circle one <i>no power at location</i>
Static Water Level (A): <u>75</u> Feet Below Land Surface	Air Line Electric Measuring Line Steel Tape
Pumping Water Level (B): <u>NA</u> Feet Below Land Surface	Other (specify): <u>String (weight)</u>
Drawdown [(B) - (A)]: <u>NA</u> Feet Below Land Surface	For flowing well, measured shut in head: <u>NA</u> feet
Test Pumping Rate: <u>NA</u> Gallons Per Minute	Well yielded <u>NA</u> GPM with a drawdown of <u>NA</u> feet after <u>NA</u> hours of pumping
Duration of Pump Test (minimum 4 hours): <u>NA</u> hours	

I HEREBY CERTIFY that the above statements are true to the best of my knowledge.

Jones w Masow _____
 Print Name of Pump Installer and License No. (if applicable) Signature of Pump Installer

Form: OLWR-SWB-1B
RECEIVED
 APR 10 2006
 BY: OLWR