State W	/ell Report		
	Driller's Log		
Mississinni Departmen	t of Environmental Quality Aquifer:		
	well #: D -135		
Uniter: Usides un Artistation -			
	IS 39289-0631 L. S. Elevation: 961-5210		
	4-6938 (fax) E-log #:		
State Law requires that this report be prepared by the lice Department at the above address within 30 days of comp			
Information on Well Owner	Well or Borehole Location		
(Landowner if borehole is not for a water well)	Latituda 34 . 56 ,895 " Langituda 89 . 52 ,021 "		
Owner Name Cherokee Volley Golf	Latitude: $34 \cdot 56$, 895 "Longitude: $89 \cdot 52$, 021 " S 9 Method of Lat/Long (circle one): Conventional Survey,		
Mailing Address: 6635 Crupler	Method of Lat/Long (circle one): Conventional Survey,		
	USGS quad, Hand-held GPS, Survey-grade GPS		
	SE 1/ NE 1/ Sec 31 Twn 15 Rng 6W		
Olive Bleven Ms 38654 City State Zip Code			
	Distance Direction Nearest Town <u>$\partial'14$ Miles</u> <u>$5w$ of mineral wells</u>		
Telephone No. (901) $\partial 63 - 9 \partial 50$			
Well / Bore	hole Data		
Date drilling started: 5- うリーの Date drilling completed: 5- うリー	Hole depth: 183' Hole diameter: 14"		
Location of the source of any surface water used for drilling:	Αc		
Method of dosing and volume of Chlorine used in drilling and devel	opment: NA		
Logs run (circle all applicable). No log nul Electric Gamma Ray Density Sonic Neutron Other:			
Purpose of borehole (check one): Water Well Ceotechnical/Geol	Purpose of borehole (check one): Water Well Geotechnical/Geological Investigation Ground Source Heat Pump		
Seismic SurveyOther (describe) If drilling is not related to water well construction, skip the remainder of this block			
Purpose of Well (check one): Home Industrial Public Supply	Irrigation Fish Culture Other:		
	If a flowing well, method of flow regulation: Valve Other (describe)		
Static Water Level:			
Method of Measurement (circle one) steel tape electric tape air line other: String (weight.			
Well depth: 182' Well grouted to a depth of 50 feet Type of grout (circle one): Neat Cement Bentonite Mix			
Casing length: 142 feet Casing diameter: 8 inches Type of casing: puc			
Screen length: <u>40</u> feet Screen diameter: <u>8</u> inches Type of screen: <u>put</u>			
Screen slot size: inches Setting depth: From	142 feet to 182 feet		
Type of completion (circle all applicable): Gravel packed Underreamed Telescoped Open hole Natural Development			
Other (describe):	M		
Top of lap pipe or reduction in casing: feet. If telescoped or more than one screen, describe on next page			
Form: OLWR-SWR-1A			

• ·

The sketch below only required for water wells

If well telescopes,	show depths	on	sketch,
Ground Level			


.

,

/elK	Description of Formations Encountered	From (depth)	To (depth)
·····	Clay dirt.	Ground Level	12
	givel	12	25
	Blue chey	25	35
	Glovel	35	40
	Ble clay	40	80
	while soul	08	182
			1
		<u> </u>	
			ļ

Description of formations encountered must be provided for all wells and boreholes, unless specifically exempted by regulations

If more than one screen, show location of each on sketch

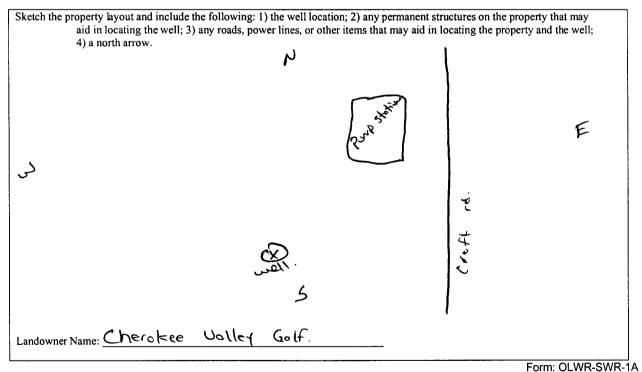

I certify that the well/borehole was drilled, constructed, and completed in accordance with all applicable requirements of the

Mississippi Department of Environmental Quality and the Mississippi Department of Health regulations, if applicable, and state laws

 G-J1-07
 Jew w. Main

 Date
 Signature of Licensee

Print Name of Responsible Licensee and License No.

STATE WELL REPORT			
County: Desoto		art 2	For Office Use Only:
Permit #: <u>M5GW16318</u>	Pump Installer's Completion Report Mississippi Department of Environmental Quality		Aquifer:
Driller: Jones W. Moson	Office of Land and Water Resources P.O. Box 10631		
Date completed: 6-6-07	Jackson, N	IS 39289-0631	Well #: <u>D-135</u>
Copy information from block on Part 1	,	961-5210 4-6938 (fax)	Elevation:
This part of the report must be completed by			
report must be attached and both parts filed with the Department at the above address within 30 days of well completion. Well Owner Information Well Location			
Owner Name: Cherokpe Ualley			Longitude: 81,52,021
Mailing Address: 6635 crunde		Method of Lat/Long (check on	
			GPS, Survey-grade GPS
	2 84 54	<u>SE 4NE 4 Sec 31</u>	
Olive Browen Ms City State	Zip Code		
			Nearest Town
Telephone No. (90) 268 - 925	<u>></u>	<u><u> </u></u>	mineral wells.
Pump Type		Boy	ver Type
Circle one			rcle one
Air Lift Jet 🤇	Submersible	Diesel Engine Gasolin	e Engine Natural Gas
Bucket Piston	Turbine	Electric Motor Hand	Tractor PTO
Centrifugal Rotary	Flowing Well	Windmill Other (specify):
Other (specify):		Horse Power Rating of Motor:	
Date Pump Installed: 6-07		Setting Depth:	feet
Rated Pump Capacity: 500 C	Gallons Per Minute	Number of Stages:	2
Pump Test Data	·····	Method of Me	asuring Water Level
Date Well Tested: 6-6-07		Ci	rcle one
Static Water Level (A): 78 Feet B	Below Land Surface		suring Line Steel Tape
Pumping Water Level (B): <u>M</u> Feet B		Other (specify): <u>Strine</u>	flueight
Drawdown [(B) – (A)]:Feet B	Below Land Surface	For flowing well, measured sh	ut in head:feet
Test Pumping Rate: 500 Gallons Per Minute		Well yielded 500	_GPM with a drawdown of
Duration of Pump Test (minimum 4 hours): _	θų hours	feet after	<u>ેપ</u> hours of pumping

• •

I HEREBY CERTIFY that the above statements are true to the best of i	my knowledge.
Jones W. Magar 0-620	Geno w. Man
Print Name of Pump Installer and License No. (if applicable)	Signature of Pump Installer
	Form: OI M/D SM/D 1D

Form: OLWR-SWR-1B

٦