State V	Well Report		
	Part 1 – Driller's Log		
Mississippi Departm	ent of Environmental Quality	Aquifer:	
Permit #: Office of Land	and Water Resources	Well #: D-141	
). Box 2309 on, MS 39225		
Date drilling completed:)=)/a Car	I)961- 5210	L. S. Elevation:	
(601)9	61- 5228 (fax)	E-log #:	
State Law requires that this report be prepared by the l		the work and filed with the	
Department at the above address within 30 days of con Information on Well Owner		or borehole.	
(Landowner if borehole is not for a water well)			
	Latitude: 34 . 59 . 55	$2^{"}$ Longitude: $8^{\circ} \cdot 5^{\circ} \cdot \delta' \partial \mathbf{k}$	
Owner Name (w: 11: e KNox		2" Longitude: $\frac{89 \cdot 50}{99}$, $\frac{896}{99}$ ne): Conventional Survey,	
Mailing Address: 9070 crumpler rd.			
		I GPS, Survey-grade GPS	
	<u>500 1/2 Sw 1/2 Sec 16</u>	Twn IS Rng 66	
City State Zip Code	Distance Direction	Nearest Town	
		of handy corper	
Telephone No. (201) 526 - 2190		\	
Well / Bo	rehole Data		
Date drilling started: $5^{-}\partial 3 \cdot c \partial \partial$ Date drilling completed: $5^{-}\partial 3$	-08 Hole depth: <u>290</u>	Hole diameter: 63/4	
Location of the source of any surface, water used for drilling: At	٨		
Location of the source of any surface water used for drilling: <u>NA</u> Method of dosing and volume of Chlorine used in drilling and development: <u>MA</u>			
Logs run (circle all applicable) No log rup Electric Gamma Ray Density Sonic Neutron Other:			
	Name of organization running log(s):		
Purpose of borehole (check one): Water Well Geotechnical/Ge	ological Investigation Ground	d Source Heat Pump	
Seismic Survey Other (<i>descri</i>	Seismic Survey Other (<i>describe</i>)		
If drilling is not related to water well construction, skip the remainder of this block			
Purpose of Well (check one): Home Industrial Public Supply Irrigation Fish Culture Other:			
If a flowing well, method of flow regulation: Valve A	Other (describe)		
Static Water Level: 160' feet above of below (circle one) land surface Date measured: 6-2-08			
Method of Measurement (circle one) steel tape electric tape air line other: String lucight			
Well depth: $\frac{\partial 90}{\partial 10}$ Well grouted to a depth of <u>50</u> feet Type of grout (circle one): Neat Cement Bentonite Mix			
Casing length: 210 feet Casing diameter: <u>Y</u> inches Type of casing: $\rho \cup \zeta$			
Screen length: $\frac{\partial O}{\partial t}$ feet Screen diameter: $\underline{\gamma}$ inches Type of screen: $\underline{\rho \cup c}$			
Screen slot size: ,010 inches Setting depth: From 270 feet to 290 feet			
Type of completion (circle all applicable): Gravel packet Underreamed Telescoped Open hole Natural Development			
Other (describe):			
Top of lap pipe or reduction in casing:	telescoped or more than one scre	een, describe on next page	
		Form: OLWR-SWR-1A (04/08)	

b.

.

•

JUN 2 4 2008 BY: OLWR

-141


The sketch below only required for water wells

If well telescopes,	show	depths	on	sketch.
Ground Level.		7		

Description of formations encountered must be provided for all wells and boreholes, unless specifically exempted by regulations

Description of Formations Encountered	From (depth)	To (depth)
cley dift	Ground Level	25
giovel	32	40
Cock	40	પા
Blue clay	41	185
white soud	185	200
white clay	200	392
Rock	292	236
white soud	336	390
		ļ
		
		l
······		
		<u>∤</u>
	_	

If more than one screen, show location of each on sketch

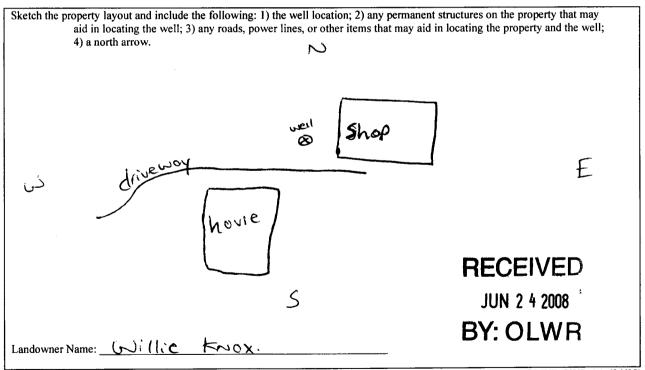

Form: OLWR-SWR-1A (04/08)

I certify that the well/borehole was drilled, constructed, and completed in accordance with all applicable requirements of the Mississippi Department of Environmental Quality and the Mississippi Department of Health regulations, if applicable, and state

laws. Tones w. Maso~ 0-670 6-20-08 Print Name of Responsible Licensee and License No. Date

Jong W. Man Signature of Licensee

Print Name of Responsible Licensee and License No.

	STATE WELL REPORT	
County: Desoto	Part 2 Pump Installer's Completion Report	For Office Use Only:
Permit #:	Mississippi Department of Environmental Quality	Aquifer:
Driller: Jones w. Mosun	Office of Land and Water Resources P.O. Box 2309	D_{-} 141
Date completed: 6-2-08	Jackson, MS 39225 (601)961-5210	Well #:
Copy information from block on Part 1	(601)961-5228 (fax)	Elevation:

, *•*

report must be attached and both parts filed with the Department at the above address within 30 days of well completion.				
	Well Owner Infor	mation	Well Location	
Owner Name: Willie KNOX			Latitude: 34.59.557 Longitude: 81-50-826	
Mailing Address:	1070 crun	pler rd.	Method of Lat/Long (check one): Conventional Survey,	
		·····	USGS quad, Hand-held GPS, Survey-grade GPS	
OI <u>-io</u>	e Bronch	MS <u>38654</u> Ite Zip Code	<u>5 w 1/4 5 w 1/4 Sec 16 T 15 R 6 w</u>	
	iy 54		Distance Direction Nearest Town	
Telephone No. (⁽¹⁰⁾	1) 536-3	190	57/8 Miles NW of handy corner	
· · · · · · · · · · · · · · · · · · ·				
	Pump Type Circle one	• •	Power Type Circle one	
Air Lift	Jet	Submersible	Diesel Engine Gasoline Engine Natural Gas	3
Bucket	Piston	Turbine	Electric Motor Hand Tractor PTO)
Centrifugal	Rotary	Flowing Well	Windmill Other (specify):	
Other (specify):			Horse Power Rating of Motor: $\partial - H P$	
Date Pump Installed:	6-2-00	<u> </u>	Setting Depth:feet	
Rated Pump Capacity	1: <u> </u>	Gallons Per Minute	Number of Stages: 14	
· · · · · · · · · · · · · · · · · · ·				
	Pump Test D	ata -	Method of Measuring Water Level Circle one	

rump rest Data	Circle one
Date Well Tested: $6 - 2 - 08^{\circ}$ Static Water Level (A): 160 Feet Below Land Surface	Air Line Electric Measuring Line Steel Tape Other (specify): <u>String (weight</u>
Pumping Water Level (B): <u>NA</u> Feet Below Land Surface	<u> </u>
Drawdown [(B) – (A)]: Feet Below Land Surface	For flowing well, measured shut in head: <u>NA</u> feet
Test Pumping Rate: 7 5 Gallons Per Minute	Well yieldedGPM with a drawdown of
Duration of Pump Test (minimum 4 hours): <u></u>	feet after <u>24</u> hours of pumping

I HEREBY CERTIFY that the above statements are true to the best of	my knowledge.
Tones J. Marin 0-620 Print Name of Pump Installer and License No. (if applicable)	Jens w. Man
Print Name of Pump Installer and License No. (if applicable)	Signature of Pump Installer
	JUN 2 4 2008
	BY: OLWR