

DESOTO MISSISSIPPI BOARD OF

D 2000

WATER WELL DRILLERS LOG

Date: 6/7/61, Driller: C. Perry County: Desoto

(1) Owner of Land	Description & Color of Materials Sand, Clay, Red Clay, Shell, etc.	Thick- ness Feet	Depth Feet
<u>Ellis Finck</u> (Name)	<u>0-16 Clay</u>		
(Address)	<u>16-26 Gravel & Sand</u>		
(2) Location: <u>1/4</u> , <u>1/4</u> , Sec. <u>16</u>	<u>26-190 Gravel</u>		
<u>3</u> miles <u>west</u> of <u>...</u>	<u>190-212 Sand</u>		
(3) Topography: <u>Hilly</u>			
(4) Purpose of Well: <u>Domestic</u>			


Information upon completion of well:

- (1) Diameter 2 inches.
- (2) Total Depth 212 feet.
- (3) Water Level 115 feet below top of ground.
- (4) Cased to 206, Size 2
- (5) Screen: Size 1 1/4, Length 5 ft
- (6) Were any formations sealed against pollution?
X yes, no.

If YES depth of formation 106 ft

Why General Practice

Drillers Remarks: annular space between casing & hole Riddled in

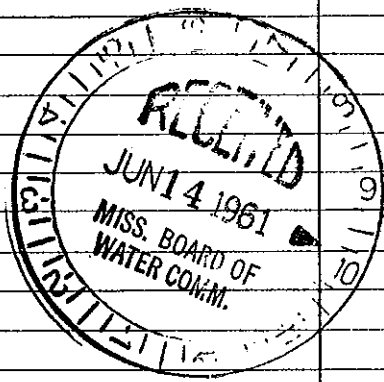

(Use Back Side)

Well No. 7