


**DESO TO** MISSISSIPPI BOARD OF WATER COMMISSIONERS

**D 2001**  
**7-15-65**

**WATER WELL DRILLERS LOG**

Date: 7-15, 1965, Driller: Harris Bros. County Lata  
Level Harris

(1) Owner of Land <u>Fred W. Price</u> (Name)	Description & Color of Materials Sand, Clay, Red Clay, Shell, etc.	Thick- ness Feet	Depth Feet
<u>Olive Branch</u> (Address)	<u>top soil</u>	<u>0</u>	<u>20</u>
(2) Location: <u>1/4</u> , <u>1/4</u> , Sec. <u>T 1 R 6</u>	<u>pea gravel</u>	<u>20</u>	<u>45</u>
_____ miles _____ of _____ (distance) (direction) (Nearest Town)	<u>grey clay</u>	<u>45</u>	<u>120</u>
(3) Topography: <u>Hilly</u> (Hilly) (Flat) (Level)	<u>clay and fine sand</u>	<u>120</u>	<u>175</u>
(4) Purpose of Well: <u>Domestic</u> (Domestic Irrigation Municipal, Industrial, Other)	<u>coarse white sand</u>	<u>175</u>	<u>194</u>
Information upon completion of well:			
(1) Diameter <u>4</u> inches.			
(2) Total Depth <u>194</u> feet.			
(3) Water Level <u>80</u> feet below top of ground.			
(4) Cased to <u>180</u> , Size <u>4"</u>			
(5) Screen: Size <u>4"</u> , Length <u>14'</u>			
(6) Were any formations sealed against pollution? _____ yes, _____ no.			
If YES depth of formation _____			
Why _____			
Drillers Remarks: _____			
_____			
_____			
_____			

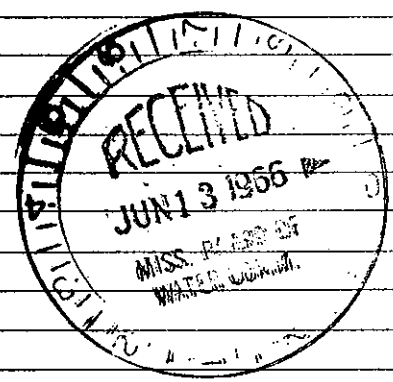

Well No.

(Use Back Side)

Mail this copy to Board of Water Commissioners 429 Miss. St. Jackson, Miss.