


DeSoto
D 2003
6-27-75

MISSISSIPPI
BOARD OF WATER COMMISSIONERS
416 North State Street
Jackson, Mississippi 39201

WATER WELL DRILLERS LOG

6-27 1975 ^{16R} W.G. Mason ^{Water Well} Contractor DeSoto
date well completed firm name county well located

LANDOWNER:	description of formations encountered	from	to
Cjay Company			
Olive Branch Miss (mailing address)	gravel	10	35
WELL LOCATION:	white clay	35	100
sec. 29 T 1 N R 5 E 1/2 miles North Haney Corner (distance) (direction) (nearest town)	white sand	100	188
WELL PURPOSE: Home (home, irrigation, municipal, industrial)			
WELL COMPLETION DATA:			
(1) diameter (inches) 4"			
(2) total depth (feet) 188'			
(3) static water level (feet) 80' below top of ground			
(4) casing (material) Plastic (depth) 168'			
4" (size) if telescope see back.			
(5) screen (length) 20' (depth to top) 168'			
4" (size) Plastic (material)			
(6) pump (HP) 3/4 (yield gpm) 10			
electric (type power)			
(7) electric log No. (yes or no)			
(organization running log)			
(8) how well bottom plugged cap on screen			
DRILLERS REMARKS:			

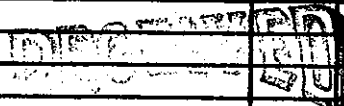

FEB 17 1976

MISS. BD. OF WATER COMM