

Desoto
E47

WATER WELL DRILLERS CODED

Date 4-17-62, 62, Driller H + H Well Co County Desoto
(Name)

(1) Owner of Land	Description & Color of Materials Sand, Clay, Red Clay, Shell, etc.	Thick- ness Feet	Depth Feet
<u>R C Jordan</u> (Name) <u>RFD Nesbitt</u> (Address)	<u>Red clay</u>	<u>60</u>	<u>79</u>
(2) Location: <u>1/4</u> , <u>1/4</u> , Sec. <u>25 T 2 R 9</u> , <u>9 W - Nesbitt</u> (distance) (direction) (Nearest Town)	<u>sand + red gravel</u>	<u>19</u>	
(3) Topography: <input checked="" type="checkbox"/> (Hilly) <input type="checkbox"/> (Flat) <input type="checkbox"/> (Level)			
(4) Purpose of Well: <u>Home</u> (Domestic Irrigation Municipal, Industrial, Other)			

CODED

Information upon completion of well:


- (1) Diameter 2 inches.
- (2) Total Depth 79 feet.
- (3) Water Level 56 feet below top of ground.
- (4) Cased to 73, Size 2.
- (5) Screen: Size 1/4, Length 6.
- (6) Were any formations sealed against pollution?
_____ yes, _____ no.

Rod Pump

If YES depth of formation _____

Why _____

Drillers Remarks: _____

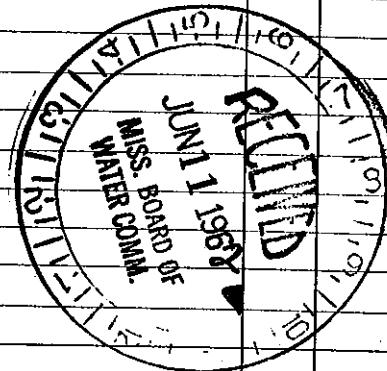

8

Well No.

(Use Back Side)

Retain this copy for your office files.