

Desoto
E48
6-66


MISSISSIPPI BOARD OF WATER COMMISSIONERS

WATER WELL DRILLERS LOG **CODED**

Date: 6-22-, 1966, Driller: Carloss Well Supply County DeSoto
(Name)

	Description & Color of Materials Sand, Clay, Red Clay, Shell, etc.	Thick- ness Feet	Depth Feet
(1) Owner of Land: <u>Dr. Ralph E. Braden</u> (Name)			
1082 Audubon Drive - Memphis, Tenn. (Address)			
(2) Location: <u>1/4</u> , <u>1/4</u> , Sec. <u>15 on 22</u> <u>72</u> <u>109</u>	Top Surface Soil -- Clay	12'	12'
<u>3</u> miles <u>East</u> , of Highway 61 (distance) (direction) (Nearest Town)	Sand & Gravel	28'	40'
at Lake Cormorant Turn-Off, Miss.	Shale	20'	60'
(3) Topography: <u>Hilly</u> (Hilly) (Flat) (Level)	Sand -- Med. Size	27'	87'
(4) Purpose of Well: <u>Irrigation</u> (Domestic Irrigation Municipal, Industrial, Other)	Blue & Gray Shale & Lignite	88'	175'
Information upon completion of well:	Gray Sand -- Fine	29'	204'
(1) Diameter <u>6</u> inches.	Gray Shale	7'	211'
(2) Total Depth <u>338</u> feet.	Gray Sand -- Fine	7'	218'
(3) Water Level: <u>72</u> feet below top of ground.	Gray Shale	14'	232'
(4) Cased to <u>305'</u> , Size <u>6"</u>	Gray Sand -- Fine	8'	240'
(5) Screen: Size <u>4"</u> , Length <u>30'</u>	Sand -- Hard Layers	30'	270'
(6) Were any formations sealed against pollution? <u>X</u> yes, _____ no.	Hard Shale	2'	272'
If YES depth of formation <u>Casing</u> cemented its entire length.	Hard Rock Layers	13'	285'
Why <u>Standard Procedure</u>	Hard Shale	10'	295'
Drillers Remarks:	Gray Sand - Med. Size	23'	318'
	Sand & Streaks White		
	Clay	20'	338'

CODED

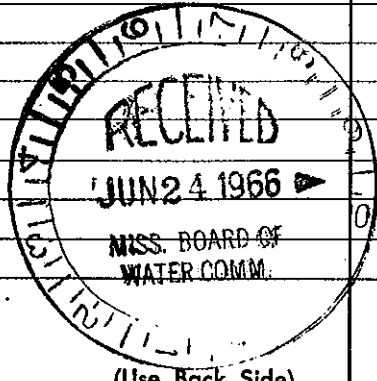

(Use Back Side)

Well No.

Mail this copy to Board of Water Commissioners 429 Miss. St. Jackson, Miss.