

State Well Report

Part 1

Mississippi Department of Environmental Quality
Office of Land and Water Resources
P.O. Box 10631
Jackson, MS 39289-0631
(601)961-5210
(601)354-6736 (fax)

County: DESOUD
Permit #: _____
Driller: BOB SMITH
Date drilling completed: 7-20-08

For Office Use Only:
Aquifer: _____
Well #: E-108
L. S. Elevator: _____
E-log #: _____

State Law requires that this report be prepared by the driller in detail and filed with the Department within 30 days of completion of drilling of the well.

Well Owner Information	Well Location
Owner Name: <u>ROYAL CONSTRUCTION</u>	Latitude: _____ Longitude: _____
Mailing Address: <u>2101 ITASCA</u>	Method of Lat/Long (circle one): <u>Conventional Survey</u>
<u>NESBIT MS 38651</u>	USGS quad, Hand-held GPS, Survey-grade GPS
City State Zip Code	<u>4</u> <u>4</u> Sec <u>35</u> Twp <u>T25</u> Rng <u>R9W</u>
Telephone No. <u>901 826-9353</u>	Distance Direction Nearest Town
	<u>3</u> Miles <u>N/E</u> of <u>EUDORA</u>

Well Data

Purpose of Well (circle one) Home Industrial Public Supply Irrigation Fish Culture Other: _____

Date well drilling started: 7-20-08 Date well drilling completed: 7-20-08

If flowing, method of flow regulation: Valve _____ Other (describe) _____

Static Water Level: 35 feet above or below (circle one) land surface Date measured: 7-20-08

Method of Measurement (circle one) steel tape elastic tape air line other: LINE + WEIGHT

Hole depth: 96 Well depth: 96 Well grouted to a depth of 10 feet

Type of grout (circle one): Cement Ductcrete Milk

Casing length: 76 feet Casing diameter: 4 inches Type of casing: PVC

Screen length: 20 feet Screen diameter: 4 inches Type of screen: PVC

Screen slot size: 137/64 inches Setting depth: From 76 feet to 96 feet

Type of completion (circle all applicable): Gravel packed Unscreened Telescoped Open hole Natural Development
Other (describe): WASHED SAND

Top of log pipe or reduction in casing: _____ feet. If telescoped or more than one screen, describe on back of page

Logs run (circle all applicable): No log run Electric Gamma Ray Density Sonic Neutron Other: _____

Name of organization running logs: _____

I certify that the well was drilled, constructed, and completed in accordance with all applicable regulations of the Mississippi Department of Environmental Quality under the Mississippi Department of Health regulations and state law.

BOB SMITH 0645 [Signature]
Print Name of Water Well Contractor and License No. Signature of Water Well Contractor

RECEIVED
AUG 18 2008
BY: OLWR

STATE WELL REPORT

Part 2

Pump Installer's Completion Report
 Mississippi Department of Environmental Quality
 Office of Land and Water Resources
 P.O. Box 10631
 Jackson, MS 39289-0631
 (601)961-5210
 (601)354-6938 (fax)

County: DESOTO
 Permit #: _____
 Driller: BOB SMITH
 Date completed: 7-20-08

For Office Use Only:

Aquifer: _____
 Well #: E-108
 Elevation: _____

This report should be prepared by the pump installer in detail and filed with the Department within 30 days of the installation of pump.

Well Owner Information	Well Location
Owner Name: <u>ROYA CONSTRUCTION</u>	Latitude: _____ Longitude: _____
Mailing Address: <u>2101 FTASCA</u>	Method of Lat/Long (circle one): Conventional Survey, USGS quad, Hand-held GPS, Survey-grade GPS
<u>NESBIT, MS. 38651</u>	_____ 1/4 _____ 1/4 Sec <u>35</u> Twn <u>T25</u> Rng <u>R9W</u>
City State Zip Code	Distance Direction Nearest Town
Telephone No. <u>901, 826-9353</u>	<u>3</u> Miles <u>N/E</u> of <u>EVADONA</u>

Pump Type Circle one	Power Type Circle one
Air Lift Jet <input checked="" type="radio"/> <u>Submersible</u>	Diesel Engine Gasoline Engine Natural Gas
Bucket Piston Turbine	<input checked="" type="radio"/> <u>Electric Motor</u> Hand Tractor PTO
Centrifugal Rotary Flowing Well	Windmill Other (specify): _____
Other (specify): _____	Horse Power Rating of Motor: <u>3/4</u>
Date Pump Installed: <u>7-20-08</u>	Setting Depth: <u>60</u> feet
Rated Pump Capacity: <u>12</u> Gallons Per Minute	Number of Stages: <u>11</u>

Pump Test Data	Method of Measuring Water Level Circle one
Date Well Tested: <u>7-20-08</u>	Air Line Electric Measuring Line Steel Tape
Static Water Level (A): <u>35</u> Feet Below Land Surface	Other (specify): <u>LINE + WEIGHT</u>
Pumping Water Level (B): _____ Feet Below Land Surface	For flowing well, measured shut in head: _____ feet
Drawdown [(B) - (A)]: _____ Feet Below Land Surface	Well yielded <u>15</u> GPM with a drawdown of _____ feet after _____ hours of pumping
Test Pumping Rate: <u>15</u> Gallons Per Minute	
Duration of Pump Test (minimum 4 hours): _____ hours	

I HEREBY CERTIFY that the above statements are true to the best of my knowledge.

BOB SMITH 0-645 _____
 Print Name of Pump Installer and License No. (if applicable) Signature of Pump Installer

RECEIVED
 AUG 18 2008
 BY: OLWR

E-108

Ground Level


Description of Formations Encountered

From To

Description of Formations Encountered	From	To
TOP SOIL	0	5
Brown CIAI	5	38
Light Gray CIAI	38	50
Red Sand + Gravel	50	96

If more than one screen, show location of each on sketch

Sketch the property layout and include the following: 1) the well location; 2) any permanent structures on the property that may aid in locating the well; 3) any roads, power lines, or other items that may aid in locating the property and the well; 4) indicate direction.

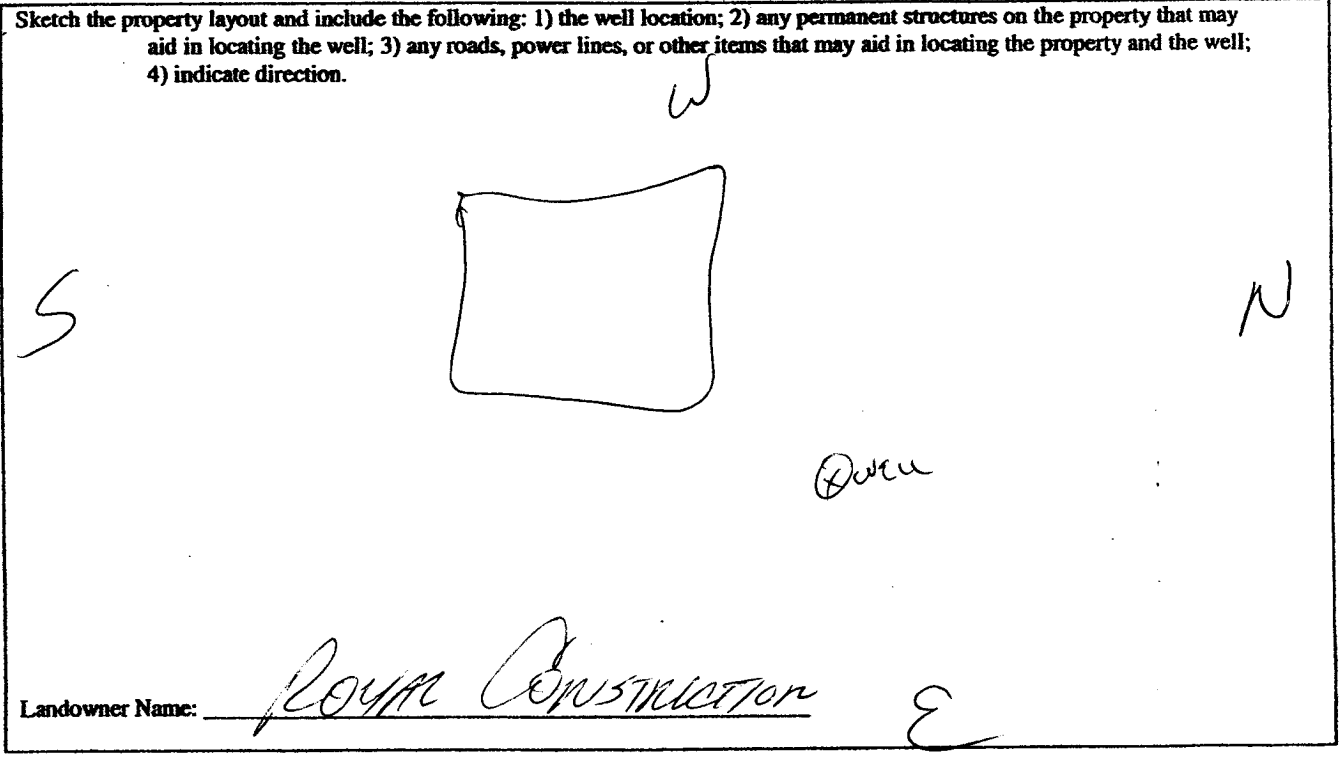

Landowner Name: ROYAL CONSTRUCTION E

[Signature]
Signature of Water Well Contractor

RECEIVED
AUG 18 2008
BY: OLWR