	Vell Report	For Office Use Only:
	Driller's Log ent of Environmental Quality	Aquifer: <u>E</u> /20
	and Water Resources	
P.0	. Box 2309 on, MS 39225	Well #:
Data drilling completed 1 - (P - OQ) (601	)961- 5210	L. S. Elevation:
(601)9	61- 5228 (fax)	E-log #:
State Law requires that this report be prepared by the li		
Department at the above address within 30 days of com Information on Well Owner		orehole Location
(Landowner if borehole is not for a water well)		
wher Name Mersino Deviatering	Method of Lat/Long (circle o	43
lailing Address: Church rd at hung 61	Method of Lat/Long (circle o	ne): Conventional Survey,
		I GPS, Survey-grade GPS
	5 1/4 Sec_8	$Twn \frac{\partial 5}{Rng} \frac{\varphi \omega}{\varphi \omega}$
City State Zip Code	NE SW 9 Distance Direction	Nearest Town
•	$3/\gamma$ Miles $SE$	of Slover
elephone No. (386) 566-3141		
Well / Bo	rehole Data	
Date drilling started: <u>11-15-09</u> Date drilling completed: <u>((-15</u>	Hole depth: 48'	Hole diameter: <u><u></u></u>
location of the source of any surface water used for drilling: $\underline{\checkmark}^{\prime}$ . Acthod of dosing and volume of Chlorine used in drilling and dev	elopment:	
Logs run (circle all applicable): No log run Electric Gamma Ra Name of organization running log(s):		
Purpose of borehole (check one): Water Well Geotechnical/Geo	ological Investigation Ground	d Source Heat Pump
Seismic Survey Other ( <i>descrit</i>	be) monitoring well to	the water level for
If drilling is not related to water well construct	ion, skip the remainder of this b	lock deuntering jub.
Purpose of Well (check one): Home Industrial Public Supp		
f a flowing well, method of flow regulation: Valve	Other (describe)	
Static Water Level:feet above or below wircle one	) land surface Date measured:	11-15-09
Aethod of Measurement (circle one) steel tape electric tap	e air line other: <u></u>	ing live ight.
Well depth: <u><b>H</b></u> Well grouted to a depth of <u><b>I</b></u> feet Type	pe of grout (circle one): Neat Cer	nent Bentonite Mix
Casing length: <u>38</u> feet Casing diameter: <u>3</u> *	inches Type of casing:	p-12
Screen length: <u>10</u> feet Screen diameter: <u>2</u> ``	inches Type of screen:	pse
Screen slot size: _, <u>010</u> inches Setting depth: From	<u>38</u> feet to	<u>ч в</u> feet
Type of completion (circle all applicable): Gravel packed Und	erreamed Telescoped Oper	n hole Natural Development
Other (describe):	· · · · · · · · · · · · · · · · · · ·	
Top of lap pipe or reduction in casing:feet. If	telescoped or more than one scr	een, describe on next page
		Form: OLWR-SWR-1A (04/08)
		SPACING
		RECEIVE

DEC 17 2009

BY: OLWR

E120

To (depth)

12


42


From (depth)

Ground Level

19


## The sketch below only required for water wells

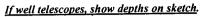

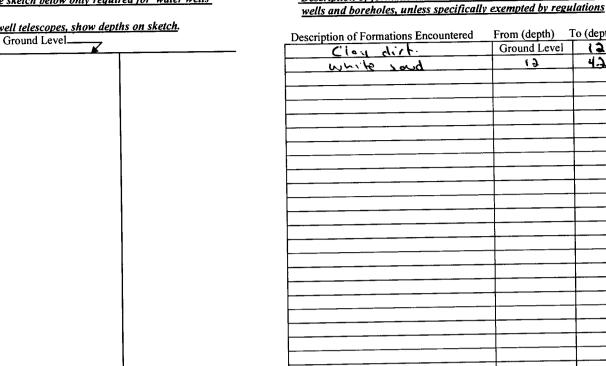

Description of formations encountered must be provided for all

If more than one screen, show location of each on sketch

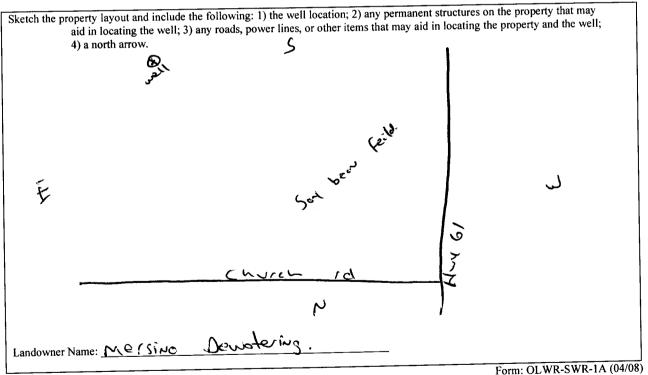

I certify that the well/borehole was drilled, constructed, and completed in accordance with all applicable requirements of the Mississippi Department of Environmental Quality and the Mississippi Department of Health regulations, if applicable, and state

laws Janes w. March 0-620 12-14-09 now. Men-HECEIVED Signature of Licensee Print Name of Responsible Licensee and License No. Date DEC 17 2009 BY: OLWR