

STATE WELL REPORT

Part 1

Driller's Log

Mississippi Department of Environmental Quality
Office of Land and Water Resources
P.O. Box 2309
Jackson, MS 39225-2309
(601)961-5210
(601)360-0535 (fax)

For Office Use Only:


Well #: E 153
Aquifer: _____
E-Log #: _____

County: Desoto
Permit #: GW-47358
Driller: Tommy Peacock
Date drilling completed: 3/22/14

State Law requires that this report be prepared by the license holder responsible for the work and filed with the Department at the above address within 30 days of completion of drilling of the well or borehole.

Well Owner Information <small>(Landowner if borehole is not for a water well)</small>	Well or Borehole Location
Owner Name: <u>Cole Crossing Farms</u>	Latitude: <u>34° 54' 23.19"</u> Longitude: <u>90° 12' 45.10"</u>
Mailing Address: <u>2100 Green Village Cove</u>	Method of Lat/Long (check one): Conventional Survey _____
<u>Hernando</u> <u>MS</u> <u>38632</u>	USGS quad _____, Hand-held GPS <u>X</u> , Survey-grade GPS _____
City State Zip Code	<u>SE ¼ SW ¼, Sec 13 T 02S R 10W</u>
Telephone No. <u>(901) 382-7570</u>	_____ Miles _____ of _____ (Distance) (Direction) (Nearest Town)

Well / Borehole Data
Date drilling started: <u>3/22/14</u> Date drilling completed: <u>3/22/14</u> Hole depth: <u>115'</u> Hole diameter: <u>26"</u>
Location of the source of any surface water used for drilling: <u>Ditch 1 mile East of well site</u>
Method of dosing and volume of Chlorine used in drilling and development: <u>Chlorinated in tanker</u>
Logs run (circle all applicable): <u>(No log run)</u> Electric Gamma Ray Density Sonic Neutron Other: _____
Name of organization running log(s): _____
Purpose of borehole (circle one): Water Well <input type="checkbox"/> Geotechnical/Geological Investigation <input type="checkbox"/> Ground Source Heat Pump <input type="checkbox"/> Seismic Survey <input type="checkbox"/> Other (describe) _____
<i>If drilling is not related to water well construction, skip the remainder of this block</i>
Purpose of Well (circle all applicable): Home <input type="checkbox"/> Industrial <input type="checkbox"/> Public Supply <input type="checkbox"/> <u>Irrigation</u> <input type="checkbox"/> Fish Culture <input type="checkbox"/>
Other (describe): _____
If a flowing well, method of flow regulation: Valve _____ Other (describe) _____
Static Water Level: <u>37'</u> feet [above or below] land surface Date measured: _____ <small>(circle one)</small>
Method of measurement (circle one): Steel tape <input type="checkbox"/> Electric tape <input type="checkbox"/> Air line <input type="checkbox"/> Other (describe) _____
Well depth: <u>115</u> Well grouted to a depth of: <u>10</u> feet Type of grout (circle one): Neat Cement <input type="checkbox"/> <u>Bentonite</u> <input type="checkbox"/> Mix <input type="checkbox"/>
Casing length: <u>75</u> feet Casing diameter: <u>12</u> inches Type of casing: <u>PVC</u>
Screen length: <u>40</u> feet Screen diameter: <u>12</u> inches Type of screen: <u>PVC</u>
Screen slot size: <u>.050</u> inches Setting depth: From _____ feet to _____ feet
Type of completion (circle all applicable): <u>Gravel packed</u> <input type="checkbox"/> Underreamed <input type="checkbox"/> Open hole <input type="checkbox"/> Natural Development <input type="checkbox"/>
Other (describe): _____
Top of lap pipe or reduction in casing: _____ feet
<i>If telescoped or more than one screen, describe on next page</i>

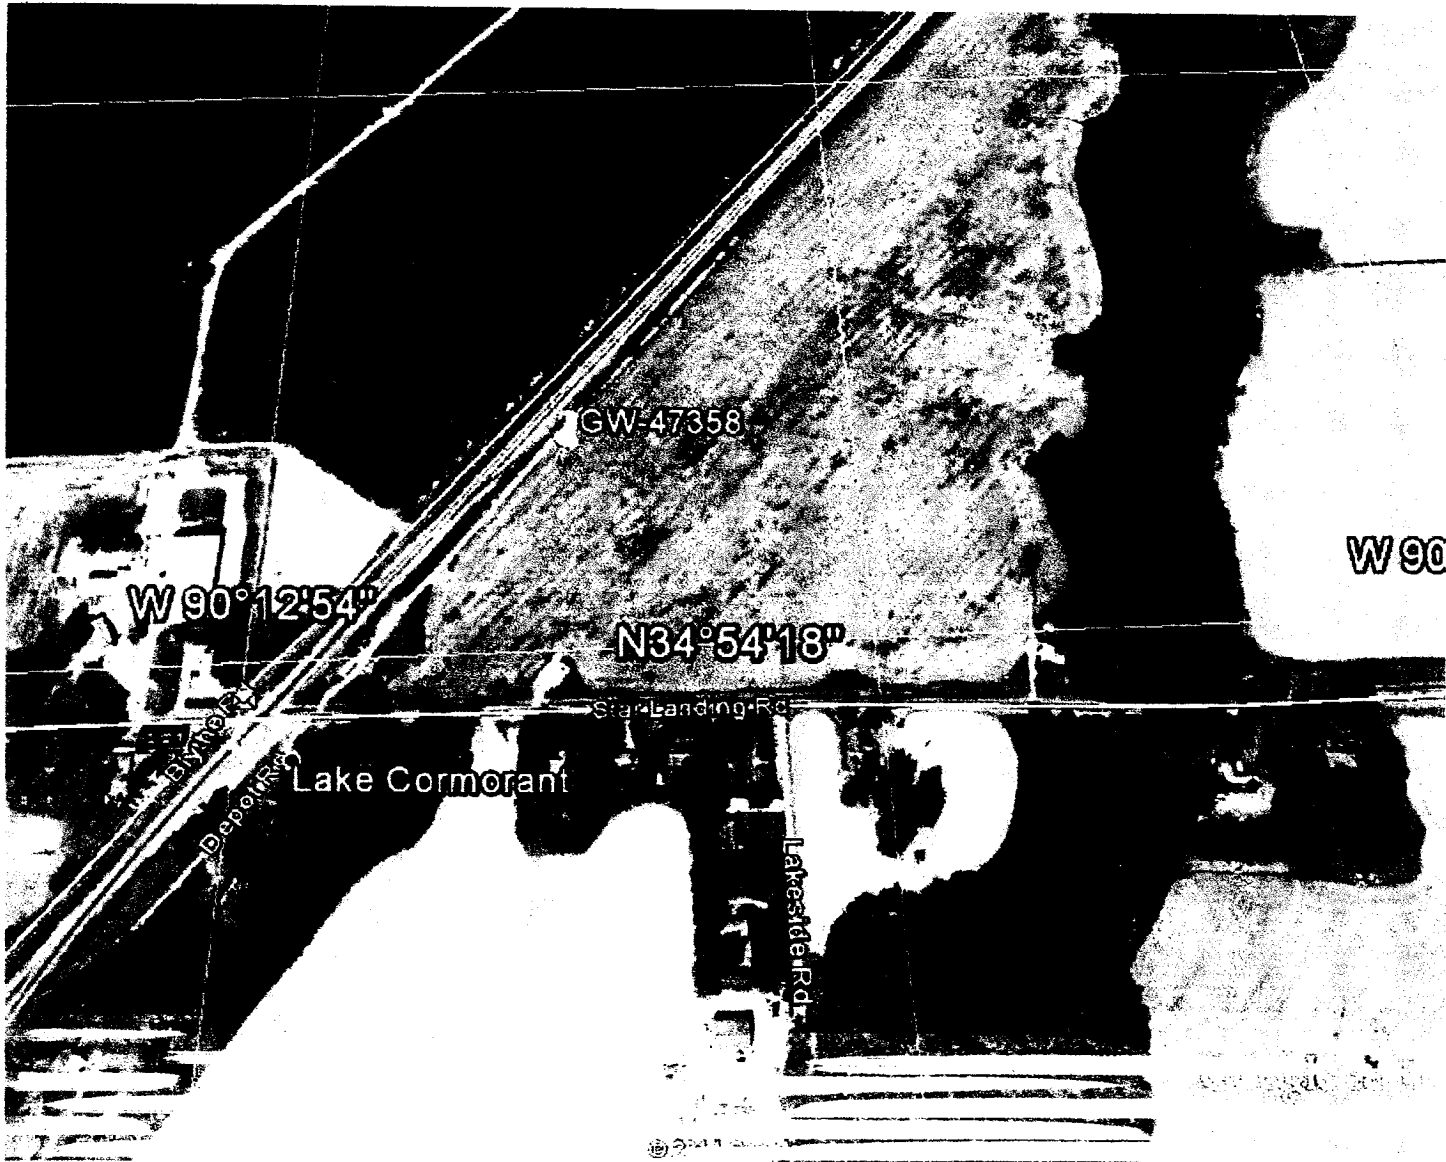

W 90°12'54"

GW-47358

N34°54'18"

W 90

Star Landing Rd

Lake Cormorant

Lakeside Rd

feet 1000
meters 400



STATE WELL REPORT

Part 2

Pump Installer's Completion Report
 Mississippi Department of Environmental Quality
 Office of Land and Water Resources
 P.O. Box 2309
 Jackson, MS 39225-2309
 (601)961-5210
 (601) 360-0535 (fax)

For Office Use Only:

Well #: E153

Aquifer: _____

County: DE SOTO
 Permit #: GW-47358
 Installer: TOMMY PERCOK
 Date completed: 3-22-14
 Copy information from block on Part 1

This part of the report must be completed by a licensed water well contractor or a licensed pump installer. A copy of Part 1 of the report must be attached and both parts filed with the Department at the above address within 30 days of well completion.

Well Owner Information	Well Location
Owner Name: <u>BLUTHE BAYOU FARMS</u>	Latitude: <u>34° 54' 18"</u> Longitude: <u>90° 12' 48"</u>
Mailing Address: <u>2100 GREENVILLE CIRCLE</u>	Method of Lat/Long (check one): Conventional Survey _____, USGS quad _____, Hand-held GPS _____, Survey-grade GPS _____
<u>HERNANDO</u> <u>MS</u> <u>38692</u>	<u>SE</u> 1/4 <u>SW</u> 1/4, Sec <u>13</u> T <u>02S</u> R <u>10W</u>
City <u>901</u> State <u>MS</u> Zip Code <u>38692</u>	<u>1/4</u> Miles <u>N</u> of <u>LAKE CORMORANT</u>
Telephone No. <u>302-7570</u>	(Distance) (Direction) (Nearest Town)

Pump Type (circle one)

Submersible Turbine Air Lift Centrifugal Flowing Well Jet Piston Rotary Other (describe): _____

Date Pump Installed: 5-29-14 Rated Pump Capacity: 800 Gallons Per Minute

Is This Pump (circle one): New Repaired Replacement

Power Type (circle one)

Electric Diesel Gasoline Natural Gas Tractor PTO Windmill Other (describe): _____

Horse Power Rating of Motor: 15 Setting Depth: 60 feet Number of Stages: 1

Pump Test Data for Non Flowing Well

Date Well Tested: _____ Duration of Pump Test (minimum 4 hours): _____ hours

Static Water Level (A): _____ Feet Below Land Surface Pumping Water Level (B): _____ Feet Below Land Surface

Drawdown [(B) - (A)]: _____ Feet Below Land Surface Test Pumping Rate: _____ Gallons Per Minute

Method of measurement (circle one): Steel tape Electric tape Air line Other (describe): _____

Pump Test Data for Flowing Well

Measured shut in head: _____ feet.

Well yielded _____ GPM with a drawdown of _____ feet after _____ hours of pumping

Meter Installation

Meter Manufacturer: McCrometer Meter Serial Number: 14-03474

Meter Model Number/Name: M03010 Type of Meter: GROUNDWATER

Totalizer Register Unit and Multiplier Factor (AF x .001, gal x 1000, etc): _____

Installation Date: 6-2-14 Meter installed by: CIRCLE 5 IRRIGATION

Is This Meter (circle one): New Repaired Replacement

Important: By submitting the above information you are certifying that this meter was installed to manufacturer standards. For agricultural wells, a list of approved meters is on the MDEQ website.

RECEIVED
 JUN 23 2014
 BY: OLWR

I HEREBY CERTIFY that the above statements are true to the best of my knowledge.

DAVID P. HOLT 0-752 P 6-20-14 _____

Print Name of Pump Installer and License No. (if applicable) Date Signature of Pump Installer

130744