County Desoto	STATA M		
County: Desoto	1	Vell Report	For Office Use Only:
County. C.S.S.S.		Driller's Log	•
DAM UCAR	Mississippi Departme	nt of Environmental Quality	Aquifer:
Permit #: 660 - 49088		and Water Resources Box 2309	Aquifer: Well# E171
Driller TEDPY LOats		n, MS 39225	
		961-5210	L. S. Elevation:
Date drilling completed:	(601)96	51- 5228 (fax)	E-log #:
State Law requires that this repo Department at the above address	ert be prepared by the UC s within 30 days of com	ense notaer responsible for i nietion of drilling of the well	or borehole.
Information on Well		Well or Bo	rehole Location
(Landowner if borehole is not f			" Longitude: <u>90 ° 11 · 43</u> "
	in Mire	Latitude: <u>STOSSZZ</u>	
Owner Name Jawlel	Darry	Method of Lat/Long (circle or	e): Conventional Survey,
Mailing Address:			
	Ry, Ol	USGS quad, Hand-held	GPS, Survey-grade GPS
id 60 ma	apry KO	NEWNWY Sec 20	Twn 025 Rng OTW
Lake Cormoral City Sta	ms 38614	Ŭ Ŭ	
Ĉity Sta	ate Zip Code	Distance Direction	Nearest Town of Lak Common
		Miles	of han - compore
Telephone No. ()			
	Well / Bore	chole Data	
ut a lui		-11	28
Date drilling started: 10/15/16 Date dr			
I ocation of the source of any surface wate	er used for drilling:	norest W.	11
Location of the source of any surface wate Method of dosing and volume of Chloring	e used in drilling and devel	lopment:	
Logs run (circle all applicable): No log ru			
Name of organization running log(s):		······································	
Purpose of borehole (check one): Water W	ell Geotechnical/Geolo	ogical Investigation Ground	Source Heat Pump
Seismic	Survey Other (describe)	)	
If drilling is not related	to water well construction	n, skip the remainder of this blo	<u>CK</u>
Purpose of Well (check one): Home h	ndustrial Public Supply	Irrigation Fish Culture	Other:
If a flowing well, method of flow regulatio	n: Valve OI	ther (describe)	
Static Water Level: 25 feet ab	ove or below (circle one) i	and surface Date measured	10/15/16
State water Level.	ioro or contra (cricie one) h	una surraco i sate inteasurcu.	
Method of Measurement (circle one) sto	eel tape electric tape	air line other:	
			A Destantion Min
Well depth: <u>// 5</u> Well grouted to a dep		-	
Casing length: 75 feet Casin	ng diameter: /b	inches Type of casing:	PUC
Screen length: <u>45</u> feet Scree	en diameter: / b (DPC)	_inches Type of screen:	P.V.C
Screen slot size: <u>'050</u> inches	Setting death: From	feet to 5	20 <sup>115</sup> feet
	ovung oopin, riom		1001
Type of completion (circle all applicable):	Gravel packed Underro	eamed Telescoped Open h	ole Natural Development
	Other (describe):	analas en les la manda	
Top of lap pipe or reduction in casing:	feet. If tele	scoped or more than one screen	I. describe on next nage
Top of lap pipe or reduction in casing:	feet. If tele	scoped or more than one screen	
Top of lap pipe or reduction in casing:	feet. If tele	iscoped or more than one screen	n, describe on next page Form: OLWR-SWR-1A (04/08)
Top of lap pipe or reduction in casing:	feet. <u>If tele</u>	scoped or more than one screen	

•




SIAIL	WELL REPORT		
County: DESOTO	Part 2	For Office Use Only:	
	aller's Completion Report artment of Environmental Quality	Well #: E 171	
	Land and Water Resources		
Date completed:Ja	P.O. Box 2309 ckson, MS 39225-2309	Aquifer:	
Copy information from block on Part 1	(601)961-5210		
This part of the report must be completed by a licensed w			
of the report must be attached and both parts filed with th Well Owner Information	he Department at the above address w Well Lu		
Owner Name: Kwel WALLIS			
Mailing Address: 1240 MitBLY RD			
Maining Address: <u>ICQO MIMDEL ED</u>			
1040 0 1 1 1 1 1 1 201 201 1	USGS quad, Hand-held GF		
LALL COLMORANT MIS 38641 City State Zip Code	$- \frac{\mu r}{4} \frac{\lambda w}{4}, \text{ sec}$	30 T 025 R 09W	
Telephone No. (901) <u>734-1358</u>	$- \frac{1 \frac{1}{2}}{(Distance)} $ Miles <u>SE</u> of (Direction)	(Nearest Town)	
		· · · · · · · · · · · · · · · · · · ·	
	Type (circle one)		
Submersible (urbine) Air Lift Centrifugal Flowing We Date Pump Installed:/0-/9-/5			
$\sim$		Gallons Per Minute	
Is This Pump (circle one): (New) Repaired Replace	ment Type (circle one)		
Electric Diesel Gasoline Natural Gas Tractor PTO			
Horse Power Rating of Motor: $40$ Setting D			
-	ata for Non Flowing Well		
Unto Wall Testady			
Date Well Tested:	1 1		
Static Water Level (A): Feet Below Land Surf	ace Pumping Water Level (B):	Feet Below Land Surface	
Static Water Level (A): Feet Below Land Surf	ace Pumping Water Level (B):	Feet Below Land Surface	
Static Water Level (A): Feet Below Land Surf Drawdown [(B) - (A)]: Feet Below Land Method of measurement ( <i>circle one</i> ): Steel tape "Electri	ace Pumping Water Level (B): Surface Test Pumping Rate: ic tape Air line Other ( <i>describe</i> ):	Feet Below Land Surface	
Static Water Level (A): Feet Below Land Surf Drawdown [(B) - (A)]: Feet Below Land Method of measurement ( <i>circle one</i> ): Steel tape * Electri Pump Test	ace Pumping Water Level (B): Surface Test Pumping Rate:	Feet Below Land Surface	
Static Water Level (A): Feet Below Land Surf Drawdown [(B) - (A)]:Feet Below Land Method of measurement ( <i>circle one</i> ): Steel tape * Electri Pump Test Measured shut in head:feet.	ace Pumping Water Level (B): Surface Test Pumping Rate: ic tape Air line Other ( <i>describe</i> ): Data for Flowing Well	Feet Below Land Surface Gallons Per Minute	
Static Water Level (A): Feet Below Land Surf Drawdown [(B) - (A)]:Feet Below Land Method of measurement ( <i>circle one</i> ): Steel tape * Electri Pump Test Measured shut in head:feet.	ace Pumping Water Level (B): Surface Test Pumping Rate: ic tape Air line Other ( <i>describe</i> ): Data for Flowing Well	Feet Below Land Surface Gallons Per Minute	
Static Water Level (A): Feet Below Land Surf Drawdown [(B) - (A)]: Feet Below Land Method of measurement ( <i>circle one</i> ): Steel tape *Electri Pump Test Measured shut in head:feet. Well yielded GPM with a drawdown of Met	ace Pumping Water Level (B):	Feet Below Land Surface Gallons Per Minute	
Static Water Level (A): Feet Below Land Surf Drawdown [(B) - (A)]:Feet Below Land Method of measurement ( <i>circle one</i> ): Steel tape *Electri Pump Test Measured shut in head:feet. Well yieldedGPM with a drawdown of Meter Manufacturer: <i>McCiometer</i>	ace Pumping Water Level (B):	Feet Below Land Surface Gallons Per Minute hours of pumping	
Static Water Level (A): Feet Below Land Surf Drawdown [(B) - (A)]: Feet Below Land Method of measurement ( <i>circle one</i> ): Steel tape "Electri Pump Test Measured shut in head:feet. Well yielded GPM with a drawdown of Meter Manufacturer: McCrometer	ace Pumping Water Level (B):	Feet Below Land Surface Gallons Per Minute hours of pumping	
Static Water Level (A): Feet Below Land Surf Drawdown [(B) - (A)]: Feet Below Land Method of measurement ( <i>circle one</i> ): Steel tape "Electri Pump Test Measured shut in head:feet. Well yielded GPM with a drawdown of Meter Manufacturer: Meter Manufacturer: Meter Model Number/Name: Totalizer Register Unit and Multiplier Factor (AF x .001,	ace Pumping Water Level (B):	Event Below Land Surface Gallons Per Minute hours of pumping	
Static Water Level (A): Feet Below Land Surf Drawdown [(B) - (A)]: Feet Below Land Method of measurement ( <i>circle one</i> ): Steel tape "Electri Pump Test Measured shut in head:feet. Well yielded GPM with a drawdown of Meter Manufacturer: Meter Manufacturer: Meter Model Number/Name: Totalizer Register Unit and Multiplier Factor (AF x .001,	ace Pumping Water Level (B):	Event Below Land Surface Gallons Per Minute hours of pumping	
Static Water Level (A): Feet Below Land Surf Drawdown [(B) - (A)]: Feet Below Land Method of measurement ( <i>circle one</i> ): Steel tape "Electri Pump Test Measured shut in head:feet. Well yielded GPM with a drawdown of Meter Manufacturer: Mosos	ace Pumping Water Level (B):	Event Below Land Surface Gallons Per Minute hours of pumping	
Static Water Level (A): Feet Below Land Surf Drawdown [(B) - (A)]: Feet Below Land Method of measurement (circle one): Steel tape "Electri Pump Test Measured shut in head:feet. Well yielded GPM with a drawdown of Meter Manufacturer: Meter Meter Manufacturer: Meter Model Number/Name: MOSOS Totalizer Register Unit and Multiplier Factor (AF x .001, Installation Date: O ~21-15 Meter installed b Is This Meter (circle one): Repaired Replace Important: By submitting the above information you are	ace Pumping Water Level (B):	Feet Below Land Surface Gallons Per Minute	<b>EIVE</b> L 2 2015
Static Water Level (A): Feet Below Land Surf Drawdown [(B) - (A)]: Feet Below Land Method of measurement (circle one): Steel tape "Electri Pump Test Measured shut in head:feet. Well yielded GPM with a drawdown of Meter Manufacturer: Meter Meter Manufacturer: Meter Model Number/Name: MO 308 Totalizer Register Unit and Multiplier Factor (AF x .001, Installation Date: /O -21-15 Meter installed b Is This Meter (circle one): New Repaired Replace Important: By submitting the above information you are For agricultural wells, a list of	ace Pumping Water Level (B):	Feet Below Land Surface Gallons Per Minute	EIVEL 2 2015 31 Manta
Static Water Level (A): Feet Below Land Surf Drawdown [(B) - (A)]: Feet Below Land Method of measurement (circle one): Steel tape "Electri Pump Test Measured shut in head:feet. Well yielded GPM with a drawdown of Meter Manufacturer: Meter Manufacturer: Meter Model Number/Name: Meter Model Number/Name: Meter Model Number/Name: Meter Model Number/Name: Meter installed b Is This Meter (circle one): New Repaired Replace Important: By submitting the above information you are For agricultural wells, a list of I HEREBY CERTIFY that the above statements are true to	ace Pumping Water Level (B):	Feet Below Land Surface Gallons Per Minute	EIVEL 2 2015 M.MARY
Static Water Level (A): Feet Below Land Surf Drawdown [(B) - (A)]: Feet Below Land Method of measurement (circle one): Steel tape "Electri Pump Test Measured shut in head:feet. Well yielded GPM with a drawdown of Meter Manufacturer: Meter Model Number/Name: Meter Model Number/Name: Meter Model Number/Name: Meter Model Number/Name: Meter Model Number/Name: Meter Model Number/Name: Meter installed b Is This Meter (circle one): New Repaired Replace Important: By submitting the above information you arr For agricultural wells, a list of I HEREBY CERTIFY that the above statements are true to DAUED P. HOLT O-757 P	ace Pumping Water Level (B):	Feet Below Land Surface Gallons Per Minute nours of pumping <u>15 - 08909</u> Dur ALATER LEG ATEON REC Ind to manufacturer standaria OV bsite.	EIVEL 2 2015 MMF
Static Water Level (A): Feet Below Land Surf Drawdown [(B) - (A)]: Feet Below Land Method of measurement (circle one): Steel tape "Electri Pump Test Measured shut in head:feet. Well yielded GPM with a drawdown of Meter Manufacturer: Meter Model Number/Name: Meter Model Number/Name: Meter Model Number/Name: Meter Model Number/Name: Meter installed b Is This Meter (circle one): New Repaired Replace Important: By submitting the above information you ar For agricultural wells, a list of I HEREBY CERTIFY that the above statements are true to	ace Pumping Water Level (B):	Feet Below Land Surface Gallons Per Minute	EIVEL 2 2015 )I.MMA


## =171

Description of formations encountered must be provided for all

## The sketch below only required for water wells

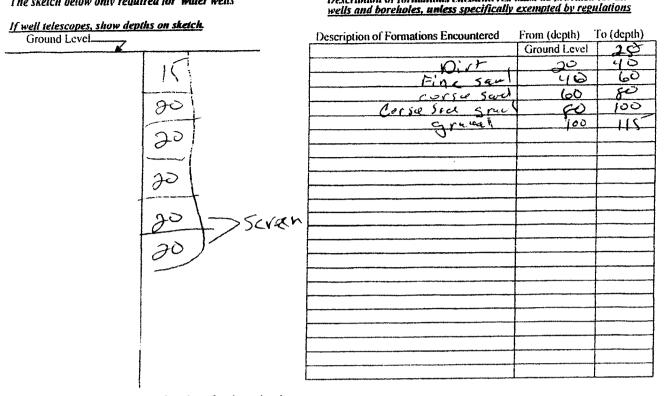

If more than one screen, show location of each on sketch

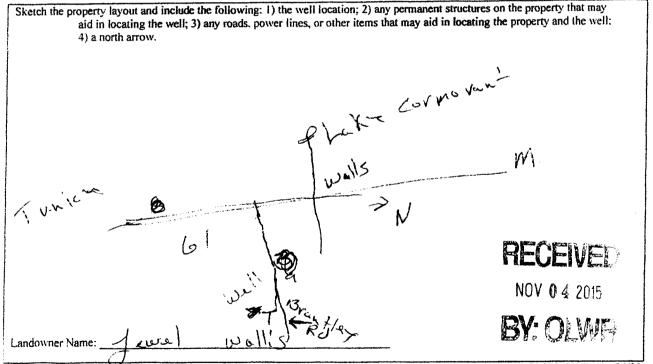

Form: OL.WR-SWR-1A (04/08)

I certify that the well/borehole was drilled, constructed, and completed in accordance with all applicable requirements of the Mississippi Department of Environmental Quality and the Mississippi Department of Health regulations, if applicable, and state

laws <u>#5318</u> 10/15/16 I License No. Date

Print Name of Responsible Licensee and License No.

Signature of Licensee