


**DESOTO**  
**E 2001**  
**3-23-76**

MISSISSIPPI  
 BOARD OF WATER COMMISSIONERS  
 416 North State Street  
 Jackson, Mississippi 39201

WATER WELL DRILLERS LOG

3-23-76 date well completed      15E 76 Bob Smith Well Dr. firm name      Desoto county well located

LANDOWNER:	description of formations encountered	from	to
<p><i>Langley Chalmer</i>  <i>Hubert, Ma.</i>            (mailing address)</p>			
<p>WELL LOCATION:</p> <p>sec. <u>3</u> T <u>2</u> N R <u>9</u> E  <i>0</i> miles <u>NE</u> of <u>Edwards</u>            (distance) (direction) (nearest town)</p>	<p>red clay</p>	5	40
<p>WELL PURPOSE: <u>Home</u>            (home, irrigation, municipal, industrial)</p>	<p>red sand &amp; stone</p>	40	76
<p>WELL COMPLETION DATA:</p> <p>(1) diameter (inches) <u>4"</u></p> <p>(2) total depth (feet) <u>76</u></p> <p>(3) static water level (feet) _____ below above top of ground.</p> <p>(4) casing <u>plastic</u> <u>76</u>            (material) (depth)            (size) if telescope see back.</p> <p>(5) screen <u>10'</u> <u>66</u>            (length) (depth to top)  <u>4"</u> <u>plastic</u>            (size) (material)</p> <p>(6) pump <u>1/3</u> <u>5</u>            (HP) (yield gpm)  <u>Elec.</u>            (type power)</p> <p>(7) electric log <u>no</u>            (yes or no)</p> <p>(organization running log)</p> <p>(8) how well bottom plugged <u>plugged</u></p>			
<p>DRILLERS REMARKS:</p>			

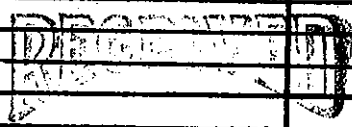

MAY 27 1976

MISS. BD. OF WATER COMM.