

DE SOTO
E 2007
8-21-78

**MISSISSIPPI
BOARD OF WATER COMMISSIONERS**
416 North State Street
Jackson, Mississippi 39201

WATER WELL DRILLERS LOG


8-21-78 date well completed Hicks well co firm name DeSoto county well located

LANDOWNER: James Moore	description of formations encountered	from	to
1582 Hwy #301 Nesbit Miss (mailing address)			
	CLAY	0	40
	RC & S	40	80
	W.S.	80	120

WELL LOCATION:
sec. 25 T-2 N R-9 E
5 miles W of Nesbit
(distance) (direction) (nearest town)

WELL PURPOSE: HOME
(home, irrigation, municipal, industrial)

- WELL COMPLETION DATA:**
- (1) diameter (inches) 4"
 - (2) total depth (feet) 120
 - (3) static water level (feet) 80 below top of ground.
 - (4) casing PVC 120 (material) (depth)
 - _____ if telescope see back. (size)
 - (5) screen 10 10 (length) (depth to top)
 - 4" 03 S107CD (size) (material)
 - (6) pump 1/2 10 (HP) (yield gpm)
 - 220 ELEC (type power)
 - (7) electric log _____ (yes or no)
 - _____ (organization running log)
 - (8) how well bottom plugged OAP

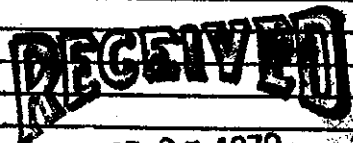

SEP 25 1978

DRILLERS REMARKS:

MISS. BD. OF WATER COMM