

DeSoto
 OF 7
 9-66
 0196

MISSISSIPPI BOARD OF WATER COMMISSIONERS

E LOG # 14

CODED

WATER WELL DRILLERS LOG

Date: 9-27, 1966, Driller: Layne-Central Co. County: DeSoto

(Name)

(1) Owner of Land:	Description & Color of Materials Sand, Clay, Red Clay, Shell, etc.	Thick- ness Feet	Depth Feet
Horn Lake Water Assn. (Name) Horn Lake, Miss. (Address)	sandy clay	0-30	470
(2) Location: 1/4, NE 1/4, Sec. 2 T. 25 S. R. 8 W.	sand-gravel	30-60	
_____ miles _____ of _____ (distance) (direction) (Nearest Town)	clay	60-225	
(3) Topography: _____ (Hilly) (Flat) (Level)	rock	225-227	
(4) Purpose of Well: municipal (Domestic Irrigation Municipal, Industrial, Other)	hard clay	227-260	
	clay-sand st.	260-290	
	sand	290-325	
	clay	325-354	
	sand	354-390	
	clay-sand st.	390-415	
	sand	415-459	
	clay-sand st.	459-470	

Information upon completion of well:


- (1) Diameter 8 inches.
- (2) Total Depth 470 feet.
- (3) Water Level 124 feet below top of ground.
- (4) Cased to 417', Size 8"
- (5) Screen: Size 6", Length 40'
- (6) Were any formations sealed against pollution?
 yes, _____ no.

If YES depth of formation 417'

Why _____ required

Drillers Remarks: _____

CODED

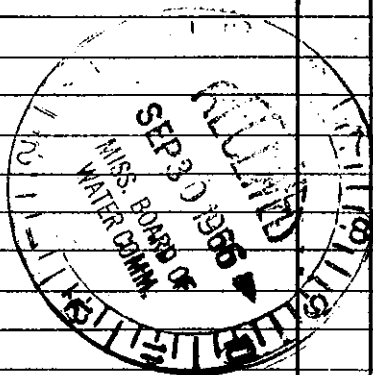

(Use Back Side)

Well No.

Mail this copy to Board of Water Commissioners 429 Miss. St. Jackson, Miss.