

De Soto
F 21
6-65

MISSISSIPPI BOARD OF WATER COMMISSIONERS

WATER WELL DRILLERS LOG

CODED

Date: 6-21- 1965, Driller: Layne-Central Co. County DeSoto


(Name)

(1) Owner of Land: <u>Nesbit Water Assn.</u> (Name)	Description & Color of Materials Sand, Clay, Red Clay, Shell, etc.	Thick- ness Feet	Depth Feet
<u>Nesbit, Mississippi</u> (Address)	clay	5	5
(2) Location: <u>1/4, S W 1/4, Sec. 21, T. 1 R. 1 E.</u>	sand-gravel	5	10
_____ miles _____ of _____ (distance) (direction) (Nearest Town)	clay	83	93
(3) Topography: _____ (Hilly) (Flat) (Level)	sandy clay	10	103
(4) Purpose of Well: <u>Municipal</u> (Domestic Irrigation Municipal, Industrial, Other)	soft sand	90	193
	clay	39	232
	sandy clay	9	241
	sand	18	259
	hard sand	26	285
	sandy clay	2	287
	hard sand	45	332

Information upon completion of well:

- (1) Diameter 10 inches.
- (2) Total Depth 327 feet.
- (3) Water Level 76 feet below top of ground.
- (4) Cased to 292, Size 8"
- (5) Screen: Size 6", Length 35'
- (6) Were any formations sealed against pollution?
X yes, _____ no.
- If YES depth of formation 292
- Why required
- Drillers Remarks: _____

CODED

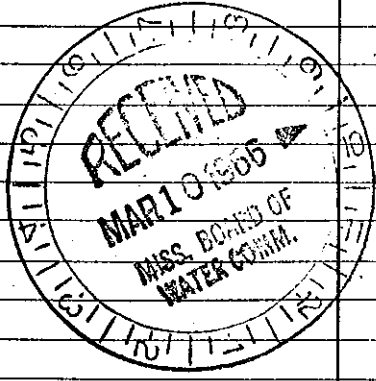

Well No.

(Use Back Side)

Mail this copy to Board of Water Commissioners 429 Miss. St. Jackson, Miss