

DESOTO

F22

10-25-66

WATER WELL DRILLERS LOG

**CODED**

Date: 10/25/66, Driller: C B Perry

County: Desoto

Wayne Baker  
(Name)

(1) Owner of Land: Wayne Baker  
(Name)

Church Rd  
(Address)

(2) Location: 12 288W  
1/4, Sec. T. R.

1/4 miles East of Hwy 51  
(distance) (direction) (Nearest Town)

(3) Topography: Hilly  
(Hilly) (Flat) (Level)

(4) Purpose of Well: Dom  
(Domestic Irrigation  
Municipal, Industrial, Other)

Description & Color of Materials  
Sand, Clay, Red Clay, Shell, etc.

Thick-  
ness  
Feet

Depth  
Feet

0-24 Clay  
24-63 Sandy gravel  
63-88 Red gravel  
88-135 fine sand  
135-145 fine sand

Information upon completion of well:

(1) Diameter 2 1/2 inches.

(2) Total Depth 145 feet.

(3) Water Level 115 feet below top of ground.

(4) Cased to 141, Size 2 1/2.

(5) Screen: Size 1 1/2, Length 4'.

(6) Were any formations sealed against pollution?


X yes, no.

If YES depth from surface

Why General Practice

Drillers Remarks:

**CODED**

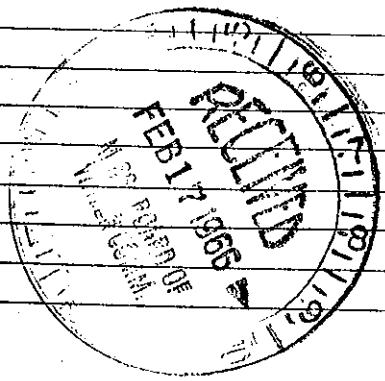

Well No.

(Use Back Side)

Retain this copy for your office files.