

CODED

MISSISSIPPI
BOARD OF WATER COMMISSIONERS
416 North State Street
Jackson, Mississippi 39201

WATER WELL DRILLERS LOG

DeVato
F42
8-68

8/2 date well completed 1968 Bob Smith firm name DeSoto county well located

LANDOWNER: Turner

description of formations encountered from to

Reslett, Miss
(mailing address)

top soil 0 70
red clay 10 40
red gravel 40 80

WELL LOCATION:

sec. 33 T. 2 R. 8 E
6 miles North of Reslett
(distance) (direction) (nearest town)

WELL PURPOSE: home
(home, irrigation, municipal, industrial)

CODED


WELL COMPLETION DATA:

- (1) diameter (inches) 4
- (2) total depth (feet) 80
- (3) static water level (feet) 50 below above top of ground.
- (4) casing plastic 80
(material) (depth)
(size) If telescope see back.
- (5) screen 20 60
(length) (depth to top)
4 plastic
(size) (material)
- (6) pump 1/2 10
(HP) (yield gpm)
Electric
(type power)

(7) electric log no
(yes or no)

(organization running log)

(8) how well bottom plugged plugged

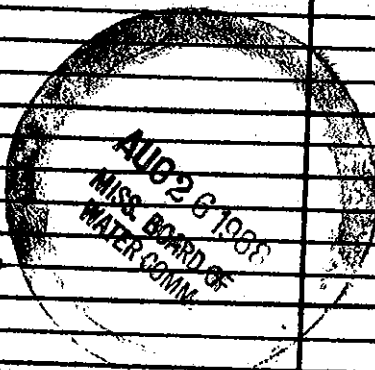

DRILLERS REMARKS:

Good drilling