

DeSoto MISSISSIPPI BOARD OF WATER COMMISSIONERS

F 44

8-29-62

WATER WELL DRILLERS LOG

CODED

Date: Aug. 29, 19 62, Driller: Deep South Well Co. County DeSoto

(Name)

(1) Owner of Land: William H. Poss
(Name)

R T D, Nesbit, Miss.
(Address)

(2) Location: 1/4, 1/4, Sec. 25 T. 2 R. 8,

1/2 miles S.E., of Nesbit
(distance) (direction) (Nearest Town)

(3) Topography: Hilly
(Hilly) (Flat) (Level)

(4) Purpose of Well: Domestic
(Domestic Irrigation
Municipal, Industrial, Other)

Description & Color of Materials
Sand, Clay, Red Clay, Shell, etc.

Thick-
ness
Feet

Depth
Feet

0-18	Surface clay	18
18-54	White clay	36
54-133	Fine sand clay	79
133-178	Fine sand ^{strks}	45
178-191	Med. coarse sand	13

CODED

Information upon completion of well:

(1) Diameter 2 1/2 inches.

(2) Total Depth 191 feet.

(3) Water Level 61 feet below top of ground.

(4) Cased to None, Size _____

(5) Screen: Size 1 1/8", Length 8 ft


(6) Were any formations sealed against pollution?

_____ yes, _____ No no.

If YES depth of formation _____

Why _____

Drillers Remarks: _____

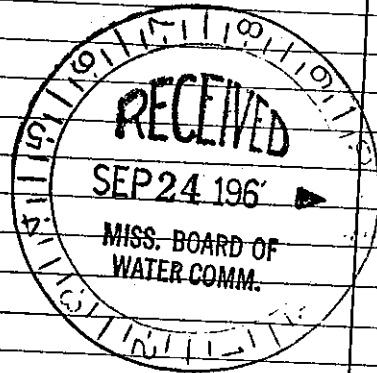

Well No.

(Use Back Side)

Mail this copy to Board of Water Commissioners 429 Miss. St. Jackson, Miss.