

Desoto

BF45 MISSISSIPPI BOARD OF WATER COMMISSIONERS

6-66

WATER WELL DRILLERS LOG

**CODED**

Date: June, 1966, Driller: Harris Bros County: Desoto  
(When well drilled) (Name) (Where well is located)

(1) Owner of Land: J. H. Lee  
(Name)  
Gorn Lake  
(Address)

(2) Location: 1/4, 1/4, Sec. 4 T 2 R 8  
miles \_\_\_\_\_ of \_\_\_\_\_  
(distance) (direction) (Nearest Town)

(3) Topography: hilly  
(Hilly) (Flat) (Level)

(4) Purpose of Well: \_\_\_\_\_  
(Domestic Irrigation  
Municipal, Industrial, Other)

Description & Color of Materials Sand, Clay, Red Clay, Shell, etc.	Thick- ness Feet	Depth Feet
<u>Top soil</u>	<u>0</u>	<u>15</u>
<u>red gravel + R. gravel</u>	<u>15</u>	<u>50</u>
<u>red clay + sand</u>	<u>50</u>	<u>85</u>
<u>coarse tan sand</u>	<u>85</u>	<u>97</u>

**CODED**

Information upon completion of well:

(1) Diameter 4 inches.

(2) Total Depth 97 feet.

(3) Water Level 30 feet below top of ground.

(4) Cased to 90, Size 4"

(5) Screen: Size 4", Length 7'

(6) Were any formations sealed against pollution?  
\_\_\_\_\_ yes, \_\_\_\_\_ no.

If YES depth of formation \_\_\_\_\_


Why \_\_\_\_\_

Drillers Remarks: \_\_\_\_\_

Yield in gpm: 10

Size pump: 3/4

Type power: electric

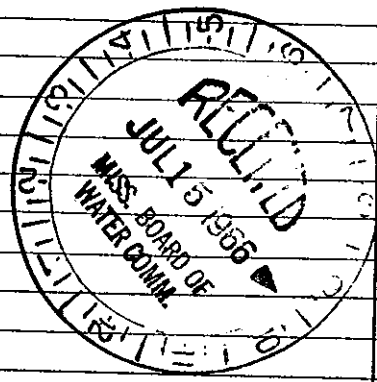

Mail this copy to Board of Water Commissioners 429 Miss. St. Jackson, Miss.