

Desoto
F 46

WATER WELL DRILLERS LOG

Date: 4-5-62, Driller: C. B. Perry County Desoto

(Name)

new-Bethlehem
 (1) Owner of Land: Church
 (Name)
Corner of Horn Lake
+ Church Rd
 (Address)
 (2) Location: 1/4, 1/4, Sec. 9, T. 2, R. 8
3 miles S.W. of HORN LAKE
 (distance) (direction) (Nearest Town)
 (3) Topography: Hilly
 (Hilly) (Flat) (Level)
 (4) Purpose of Well: Dom
 (Domestic Irrigation
 Municipal, Industrial, Other)


Description & Color of Soil	Depth Feet
<u>0-30 Clay</u>	
<u>30-35 Clay + gravel</u>	
<u>35-37 Clay</u>	
<u>37-46 Clay + gravel</u>	
<u>46-61 white Clay</u>	
<u>61-61 1/2" Soft Sand Rock (12")</u>	
<u>61-61 1/2" Clay</u>	
<u>62 Soft Sand Rock</u>	
<u>62-75 white Clay</u>	
<u>75-75 1/2" Soft Rock</u>	
<u>75 1/2-82 white Clay</u>	
<u>82-93 Blue Clay</u>	
<u>93-93'-9" Soft Rock</u>	
<u>93'-9"-15-7 Clay</u>	
<u>157-158 Hard Sand Rock</u>	
<u>158-206 tight gravel</u>	
<u>206-212 fine sand</u>	
<u>212-218 Clay</u>	
<u>218-220 fine sand</u>	
<u>220-239 coarse water sand</u>	
<u>239' at 239 Clay Bottom</u>	

CODED

Information upon completion of well:

(1) Diameter 2 inches.
 (2) Total Depth 239 feet.
 (3) Water Level 91 feet below top of ground.
 (4) Cased to 235, Size 2"
 (5) Screen: Size 1 1/4, Length 4'
 (6) Were any formations sealed against pollution?
 yes, no.

If YES depth of formation
 Why Clay riddled from surface - General practice
 Drillers Remarks:
at 239 Clay Bottom

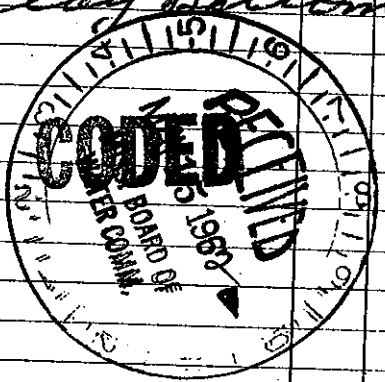

(Use Back Side)

Well No.